


T.32 S.,R.3E.,W.M.

T.33 S.,R.2E.,W.M.

28

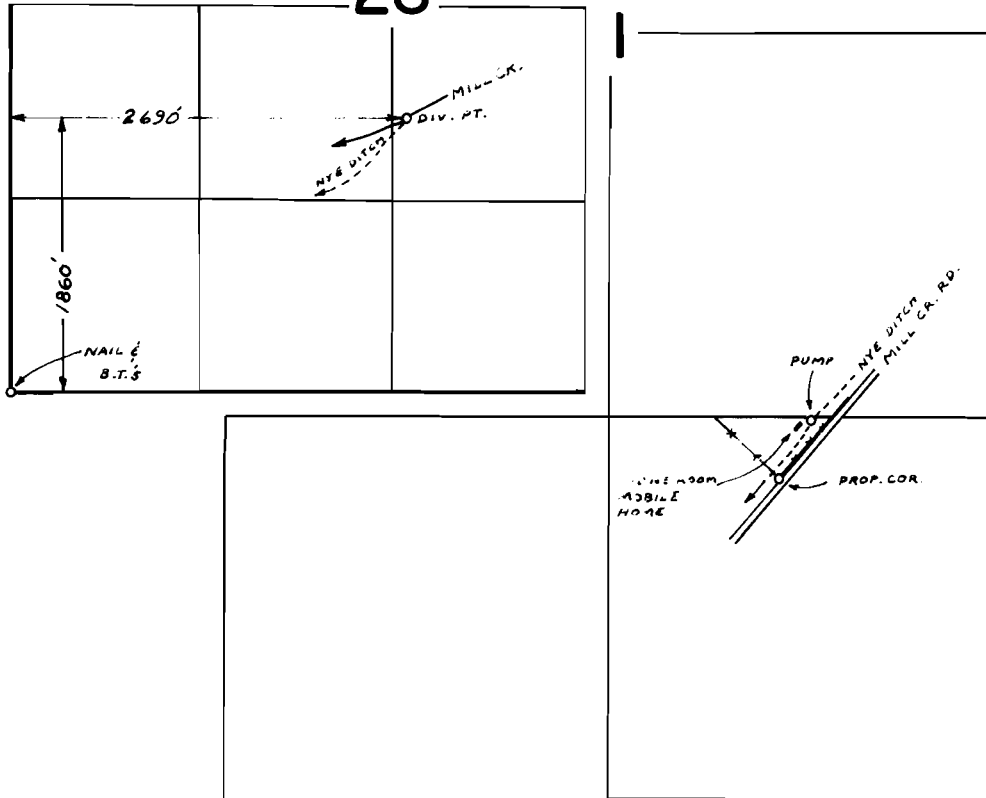

SCALE: 1" = 660 FT.

FINAL PROOF SURVEY
UNDER

Application No. 49605 Permit No. 41567
IN NAME OF

PETER JAMES OR CLORIS IONE FRISON

Surveyed AUG. 28 78 by B. SUND
19... , by