


T.38S.,R.7W.,W.M.

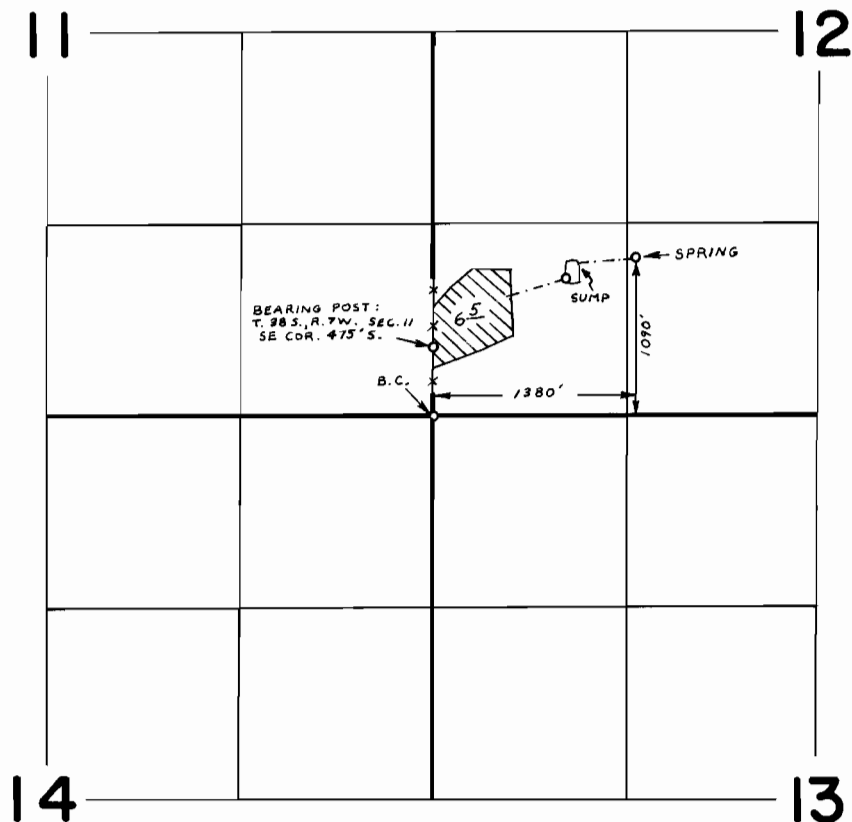

FINAL PROOF SURVEY
UNDER

Application No. 49767 Permit No. 37261
IN NAME OF

Keith & Lena Owen

Surveyed JUL. 18 1978, by B. SUND