


T. 3S., R. 2W., W.M.

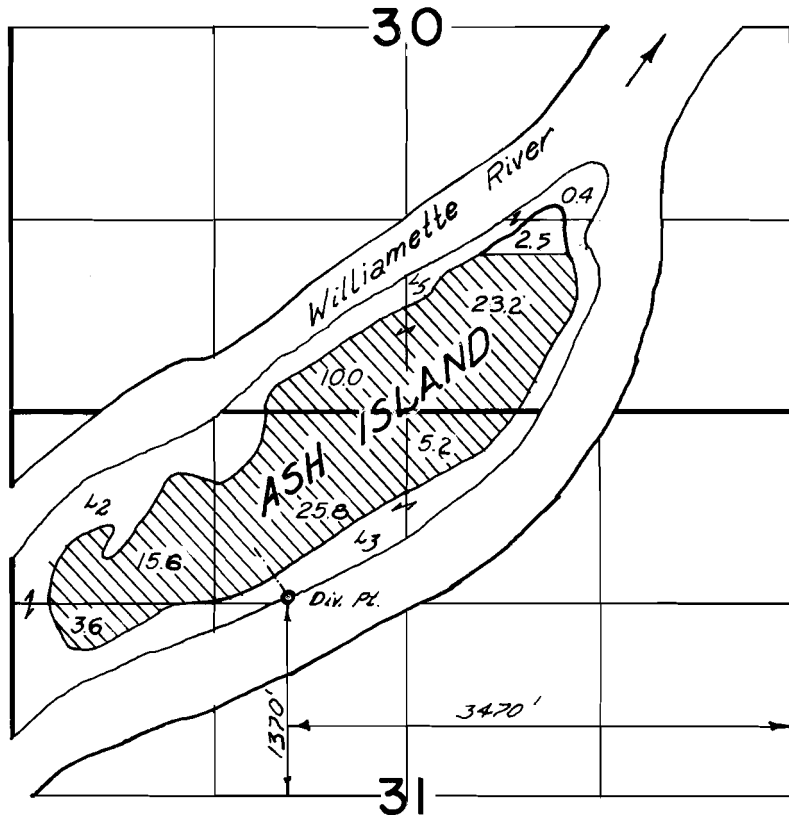

FINAL PROOF SURVEY
UNDER

Application No. 50662 Permit No. 38275

IN NAME OF

William F. Smith

Surveyed June 19, 1979, by dc Brown