


T.29S. R.11W. W.M.

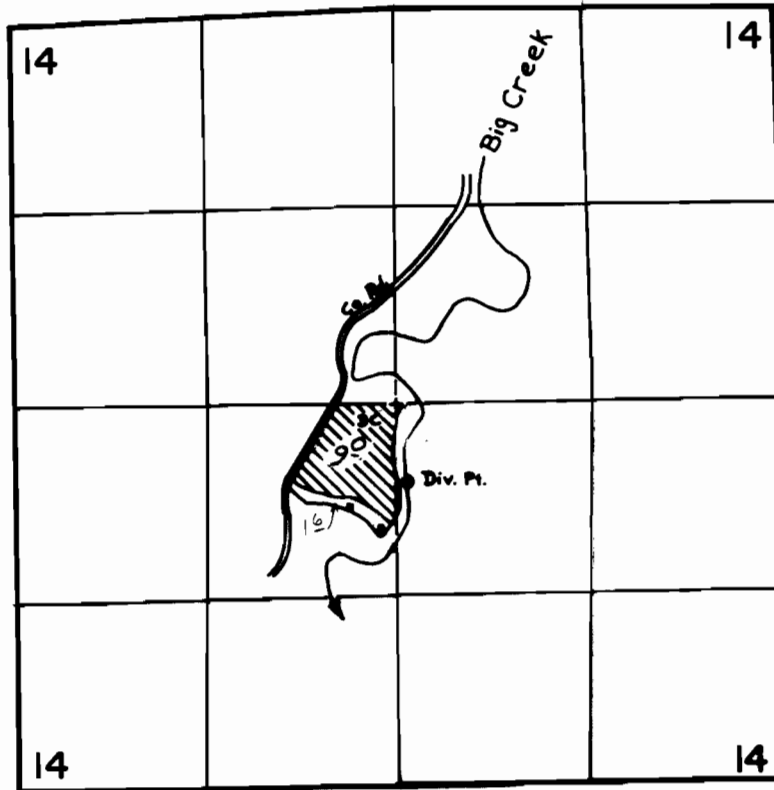

Div. Pt. Located: 530' S & 70' E from C 1/4 cor. Sec. 14

SCALE: 4" = 1 mile

FINAL PROOF SURVEY
UNDER

Application No. 51245 Permit No. 38707
IN NAME OF

CLARENCE H. KELLEY

Surveyed Aug. 8, 1979, by D.W. Sparks