


T. 24 S., R. 3 W., W. M.

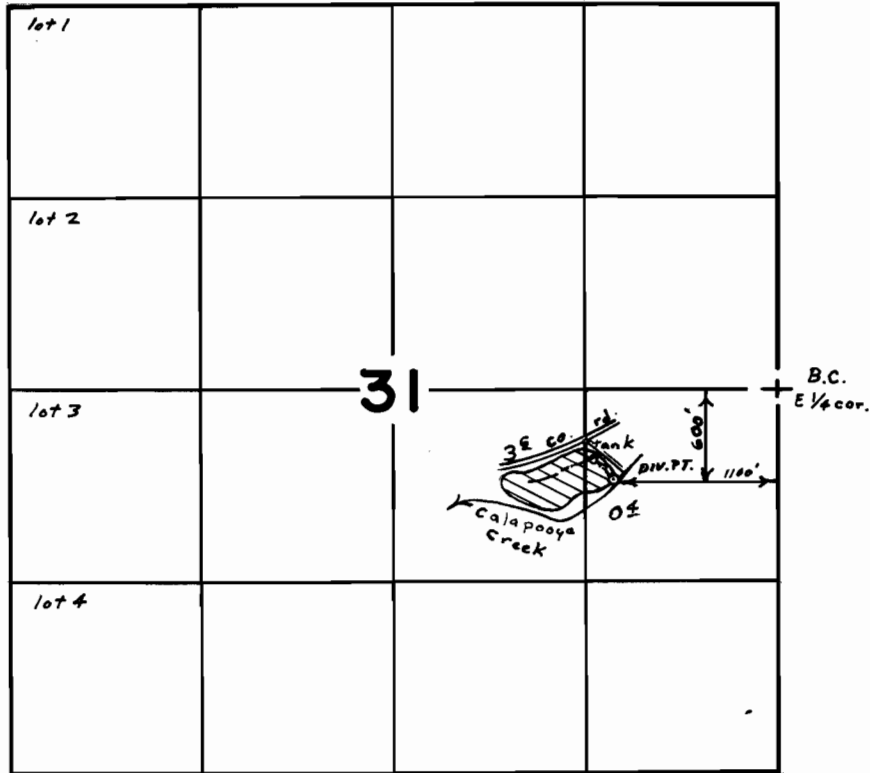

SCALE: 4" = 1 mile

FINAL PROOF SURVEY UNDER

Application No. 52,375.. Permit No. 39,404.
IN NAME OF

.....*William L. Ringo*.....

Surveyed OCT. 4, 1979, by S. DONALDSON