


T.40S., R.1E., W.M.

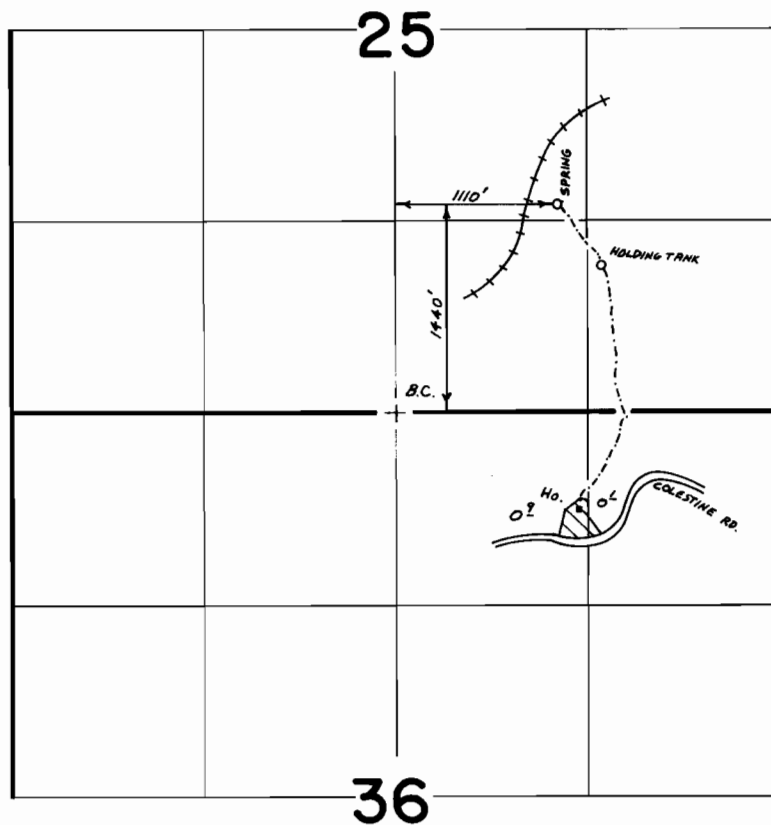

FINAL PROOF SURVEY
UNDER

Application No. **53241**.. Permit No. **39509**.....
IN NAME OF

JACK D. & JINEEN McWHERTER

Surveyed **Sept. 30, 1983**, by **B.S. JAMES**.....

Scale 4" = 1 Mile

179-134L