


T. 13S., R. 9E., W.M.

Section 15

Lot 39, Tract C,
Camp Sherman
Summer Homes

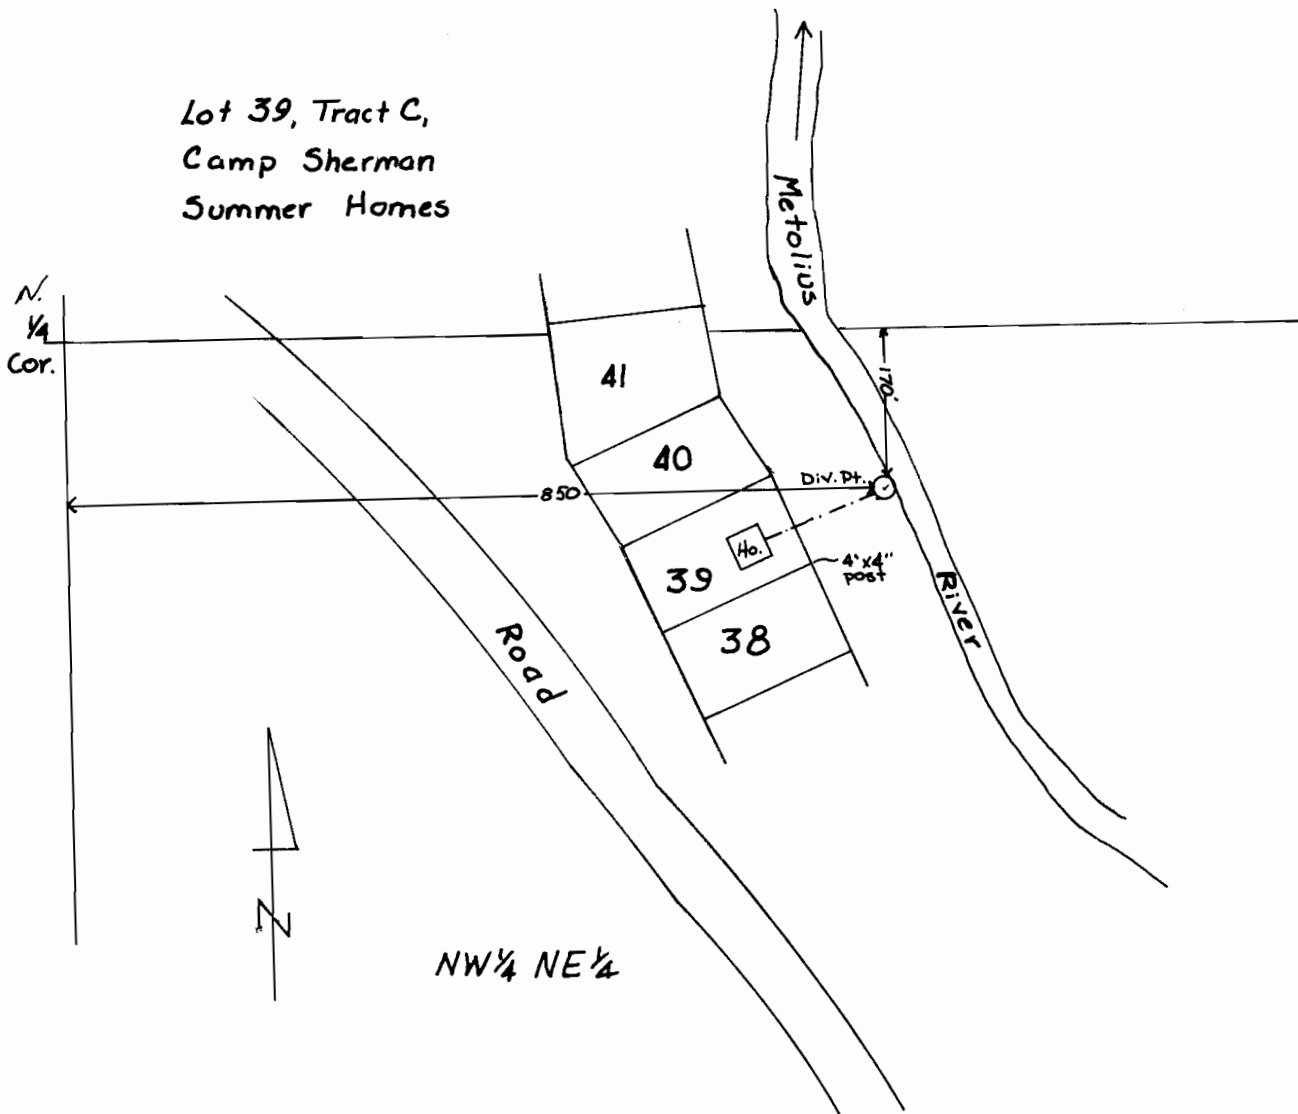

SCALE: 1"=200'

FINAL PROOF SURVEY

UNDER

Application No. 64768 Permit No. 47347

IN NAME OF

GERRY B. & MARILYN C. CAMERON

Surveyed OCT. 17, 1983, by D. PANTHER