




T.13S. R.12E. W.M.

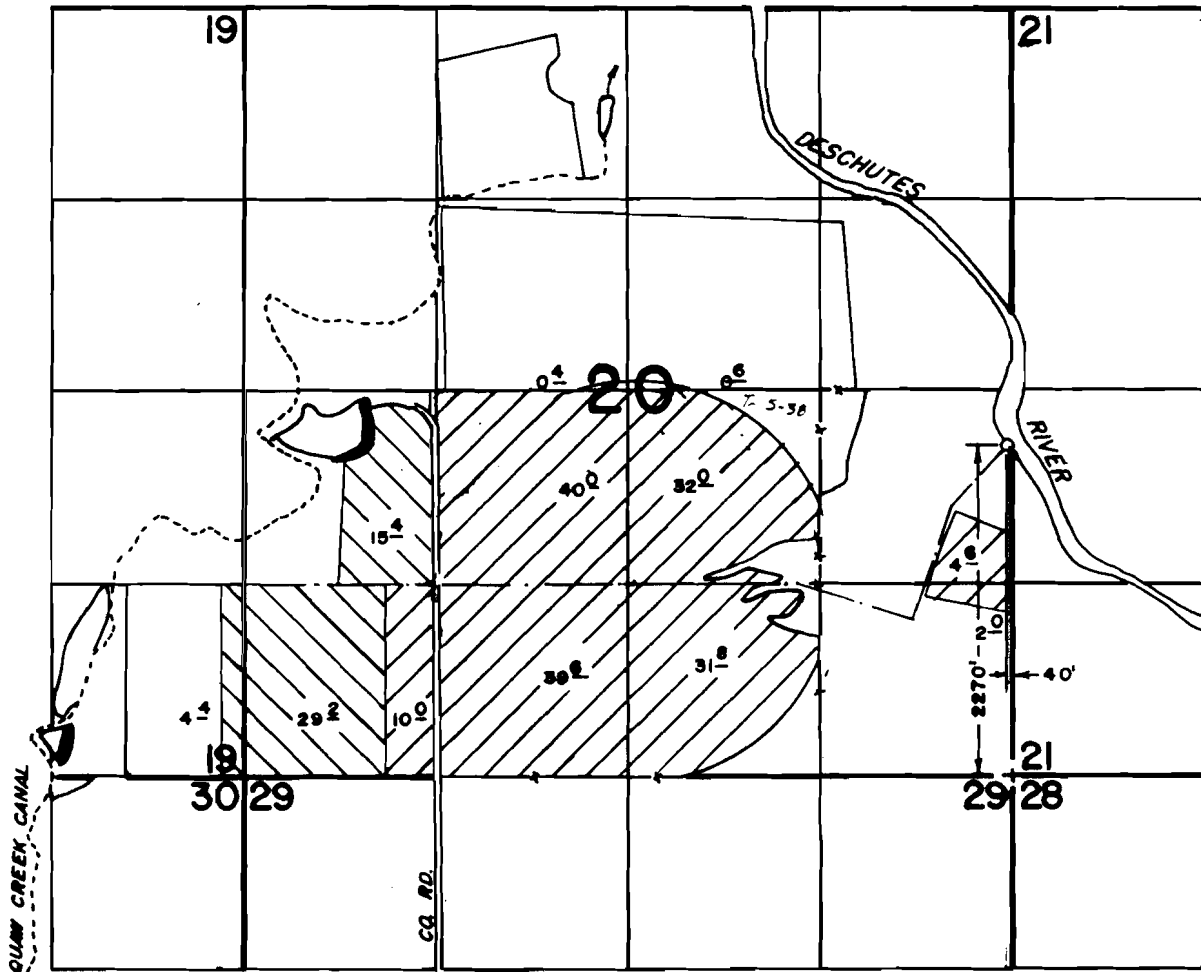

 PRIMARY
 SUPPLEMENTAL

FINAL PROOF SURVEY
UNDER

Application No. 56858... Permit No. 42753.....
IN NAME OF

.....GLENN L. COOPER.....

Cert # 51929

Surveyed MAY...8..... 1980., by L.H. NUNN.....

42753