


# T12S. R5W. WM.

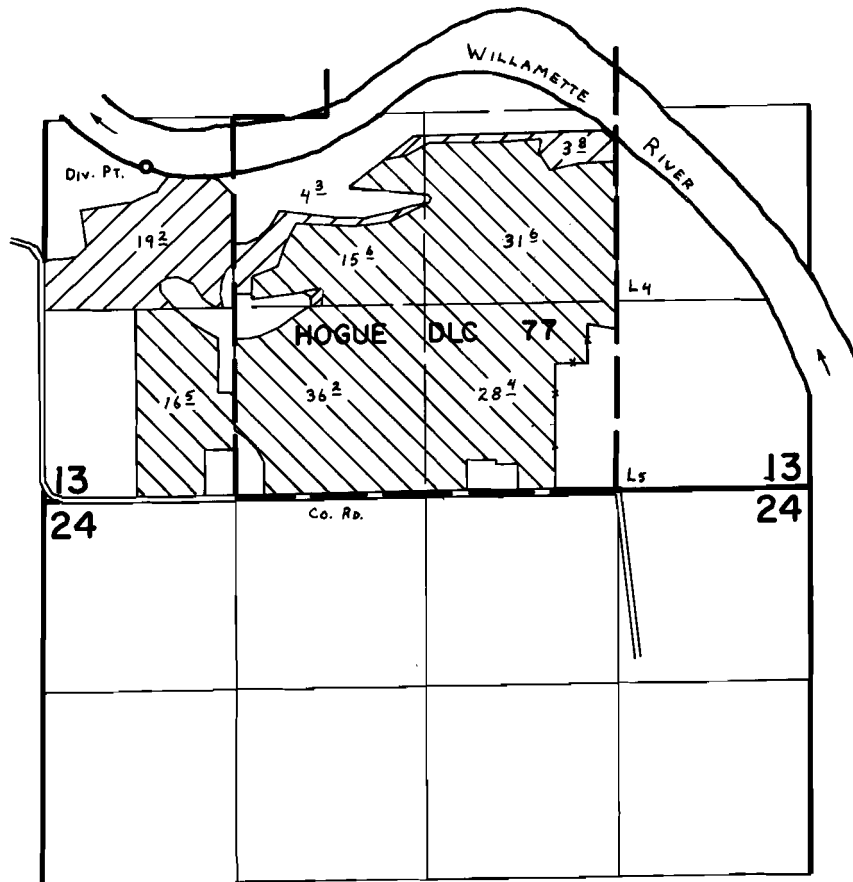

Div. Pt. Loc: 2280' N. & 690' E. fr. S.W. Cor. SEC. 13.

-  - PRIMARY IRRIGATION
-  - SUPPLEMENTAL IRRIGATION

## FINAL PROOF SURVEY UNDER

Application No. 57101 Permit No. 43036  
IN NAME OF

ROY HATHAWAY

Surveyed Oct. 3, 1979, by C. L. HUGHES