


# T7S RIW WM

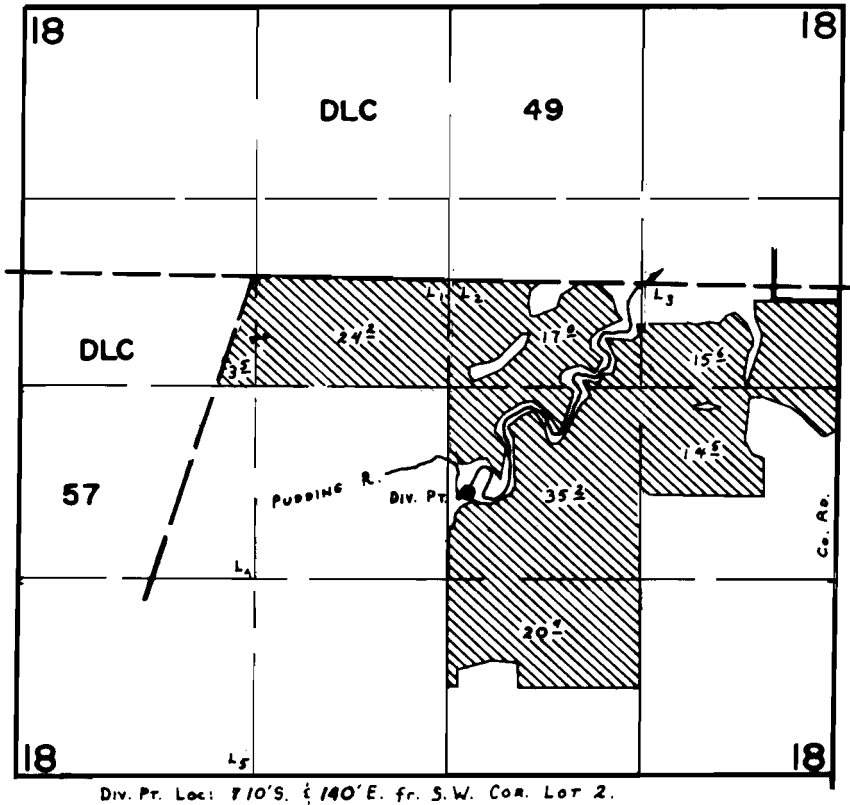

## FINAL PROOF SURVEY UNDER

Application No. **57926**. Permit No. **43766**  
IN NAME OF

**MELVIN KING**

Surveyed **JUNE 27, 1980**, by **G. L. HUENES**