


T.19S. R.40E. W.M.

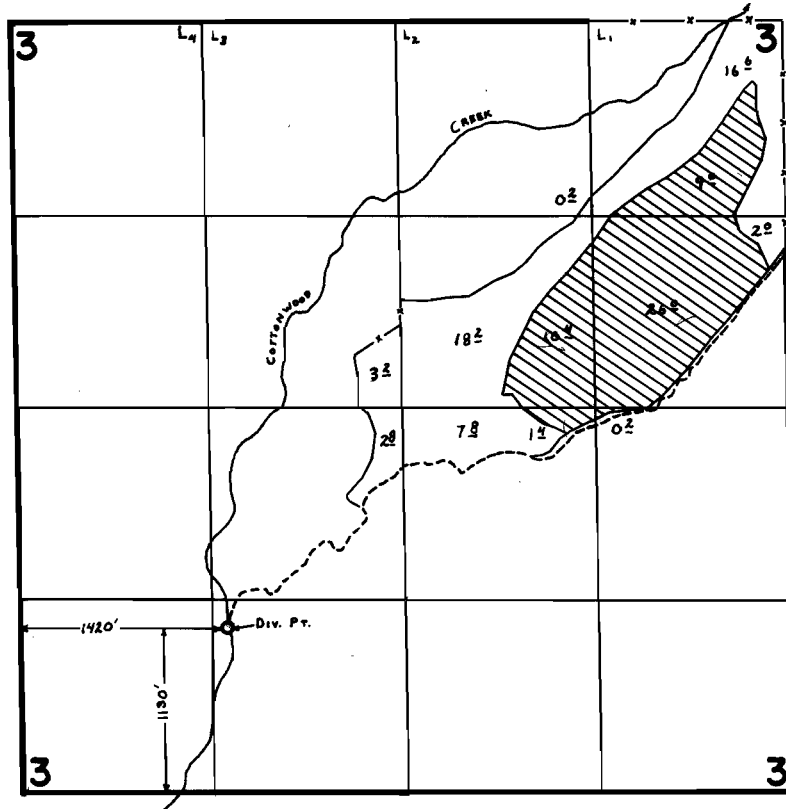

FINAL PROOF SURVEY UNDER

Application No. 57968... Permit No. 43658...
IN NAME OF

.....*Lloyd M. Hill, Inc.*.....

Surveyed Aug. 8... 1979, by C. L. HUGHES...