


P# 45359

T. 13. R. 13E. W.M.

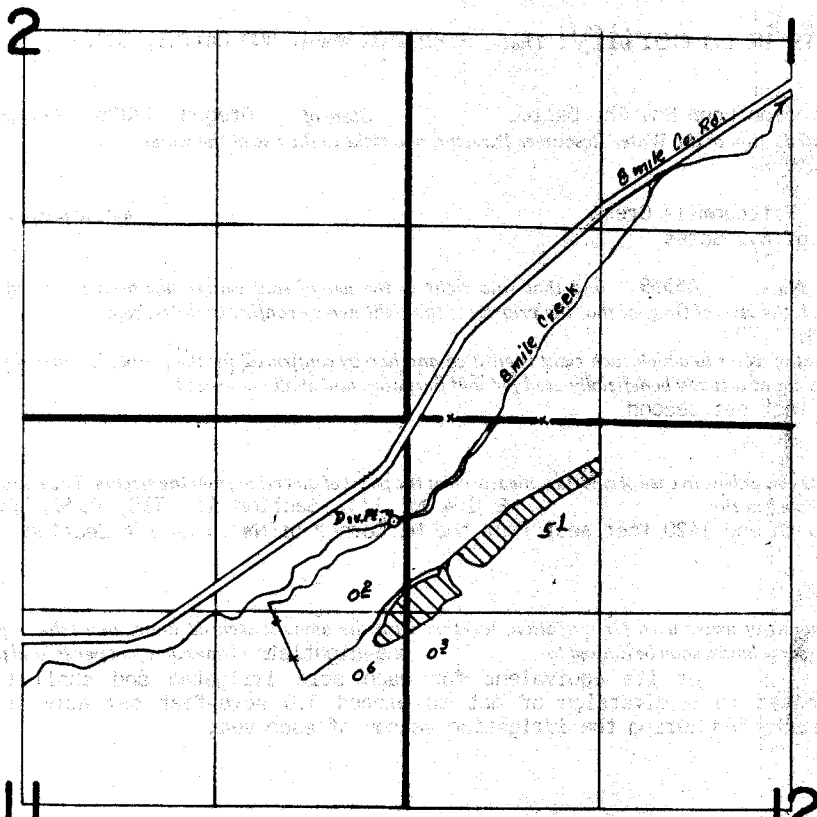

Div. Pt. Loc. 700' S. & 1420' W. From The NE Cor NW1/4 NW1/4 Sec. 12

FINAL PROOF SURVEY UNDER

Application No. 59527 Permit No. 45359
IN NAME OF

REMINGTON WHEAT & CATTLE INC.

Surveyed MAY, 3, 1983, by T. J. Paul