


T.28 S R.4 W. W.M.

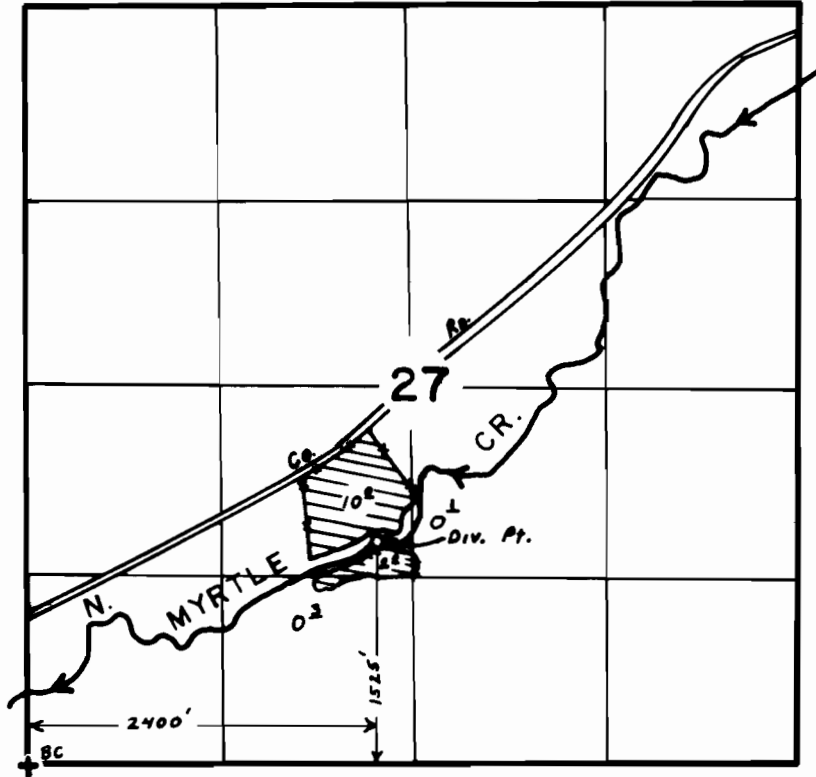

SCALE: 4" = 1 mile

FINAL PROOF SURVEY
UNDER

Application No. .60517.. Permit No. .45079.....
IN NAME OF

DOVIE LOUDERMILK

Surveyed SEPT. 29 1983., by *L. Cashman*.....