


T. 35 S., R. 3 W., W.M.

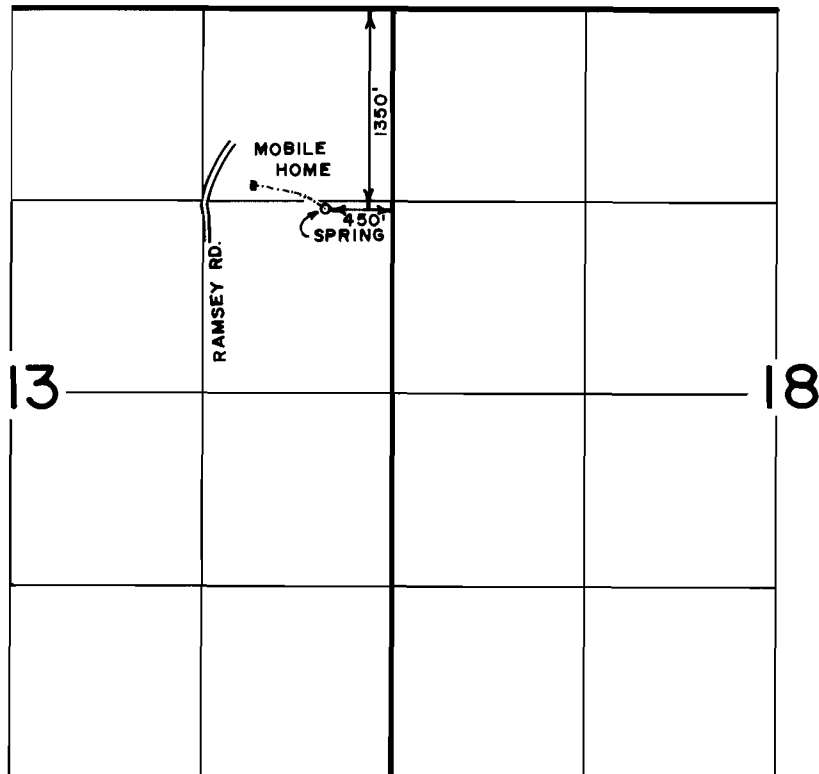

FINAL PROOF SURVEY
UNDER

Application No. 61756 Permit No. 45881
IN NAME OF

MR. LAURI ONJUKKA

Surveyed JULY 22, 1982, by B.S. JAMES

Scale : 4" = 1 Mile