


T. 13S., R. 9E., W.M.
Section 15

SE 1/4 NE 1/4

Lot 19, Tract C,
Camp Sherman
Summer Homes

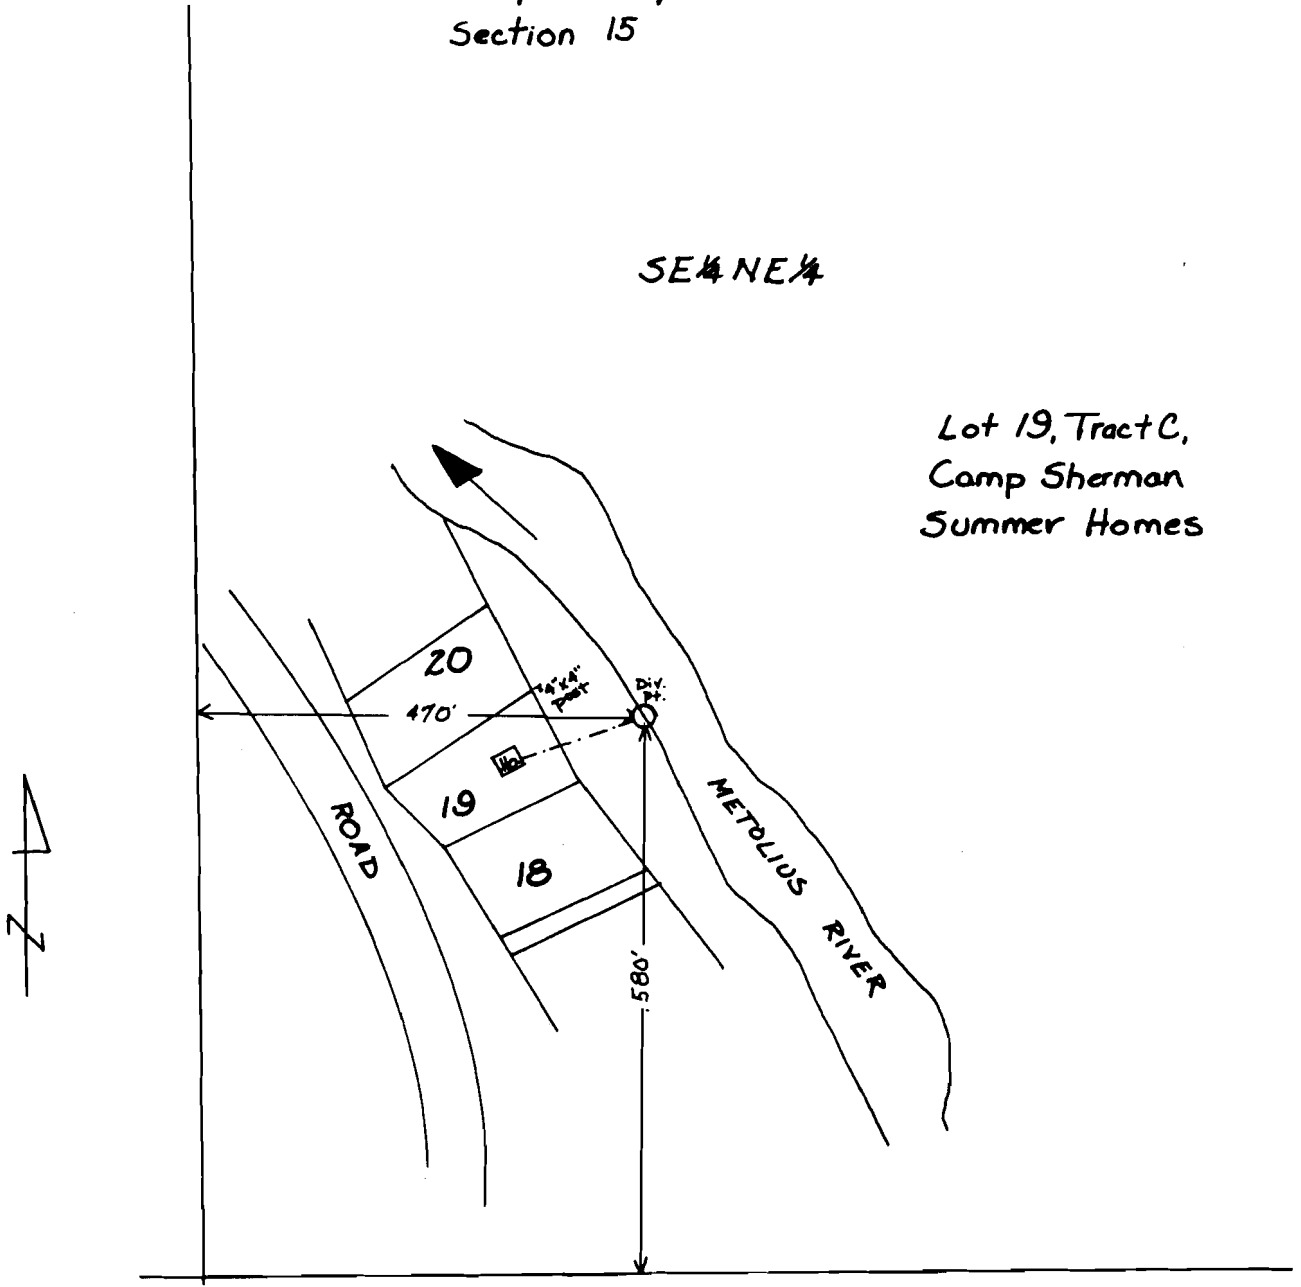

SCALE: 1" = 200'

FINAL PROOF SURVEY

UNDER

Application No. 61796 Permit No. 46242

IN NAME OF

FRANK M. & MARY M. NESBIT C. 51941

Surveyed OCT. 17, 1983, by D. PANTHER

46242
Chain Survey LGO