

T. 13S., R. 9E., W.M.

Section 10

Lake Cr.

Metolius River

Lot 42, Tract C,  
Camp Sherman  
Summer Homes

SW 1/4 SE 1/4

43

42

41


River

725'

1/4  
COR.

Road

NW 1/4 NE 1/4, Sec. 15

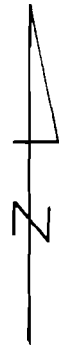

SCALE: 1"=200'

# FINAL PROOF SURVEY

UNDER

Application No. 63491 Permit No. 46866

IN NAME OF

J.H. Stuart & Bette M. McIntosh C. 51943

Surveyed OCT. 11, 1983, by B. ESTES

46866  
Chain Survey L60