


T.13S., R.9E. W.M.

Sec. 15

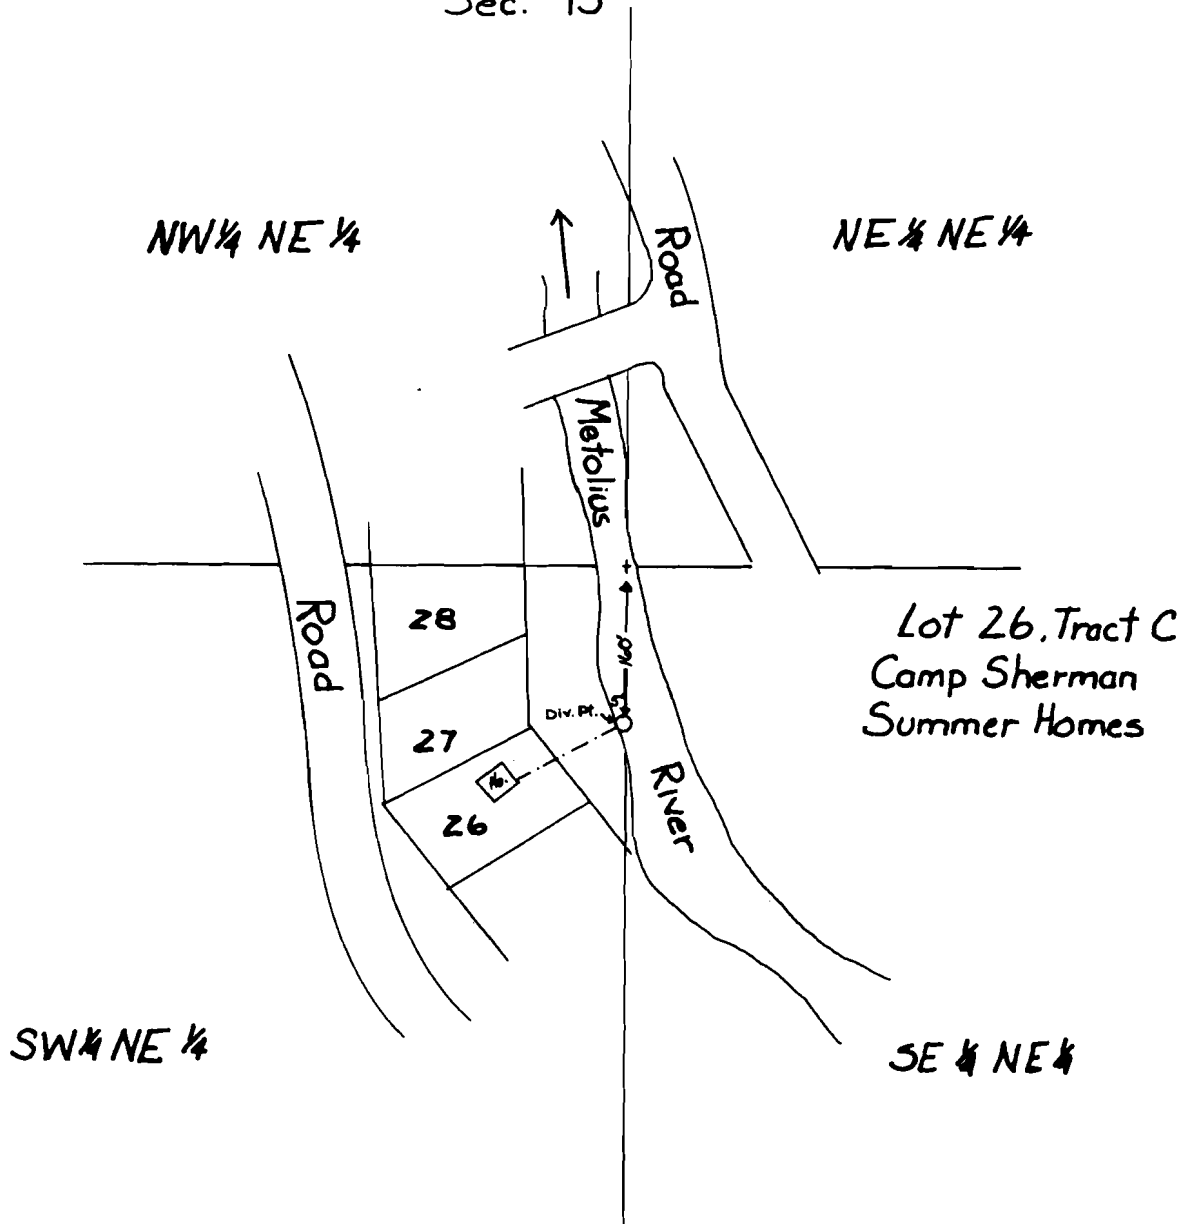

SCALE: 1"=200'

FINAL PROOF SURVEY

UNDER

Application No. 63492 Permit No. 46821 C. 51944

IN NAME OF

HAROLD E. YOUNG

Surveyed OCT. 17, 1983, by D. PANTHER

46821
Chain Survey LGO