


T. 13S., R. 9E., W.M.
Section 15

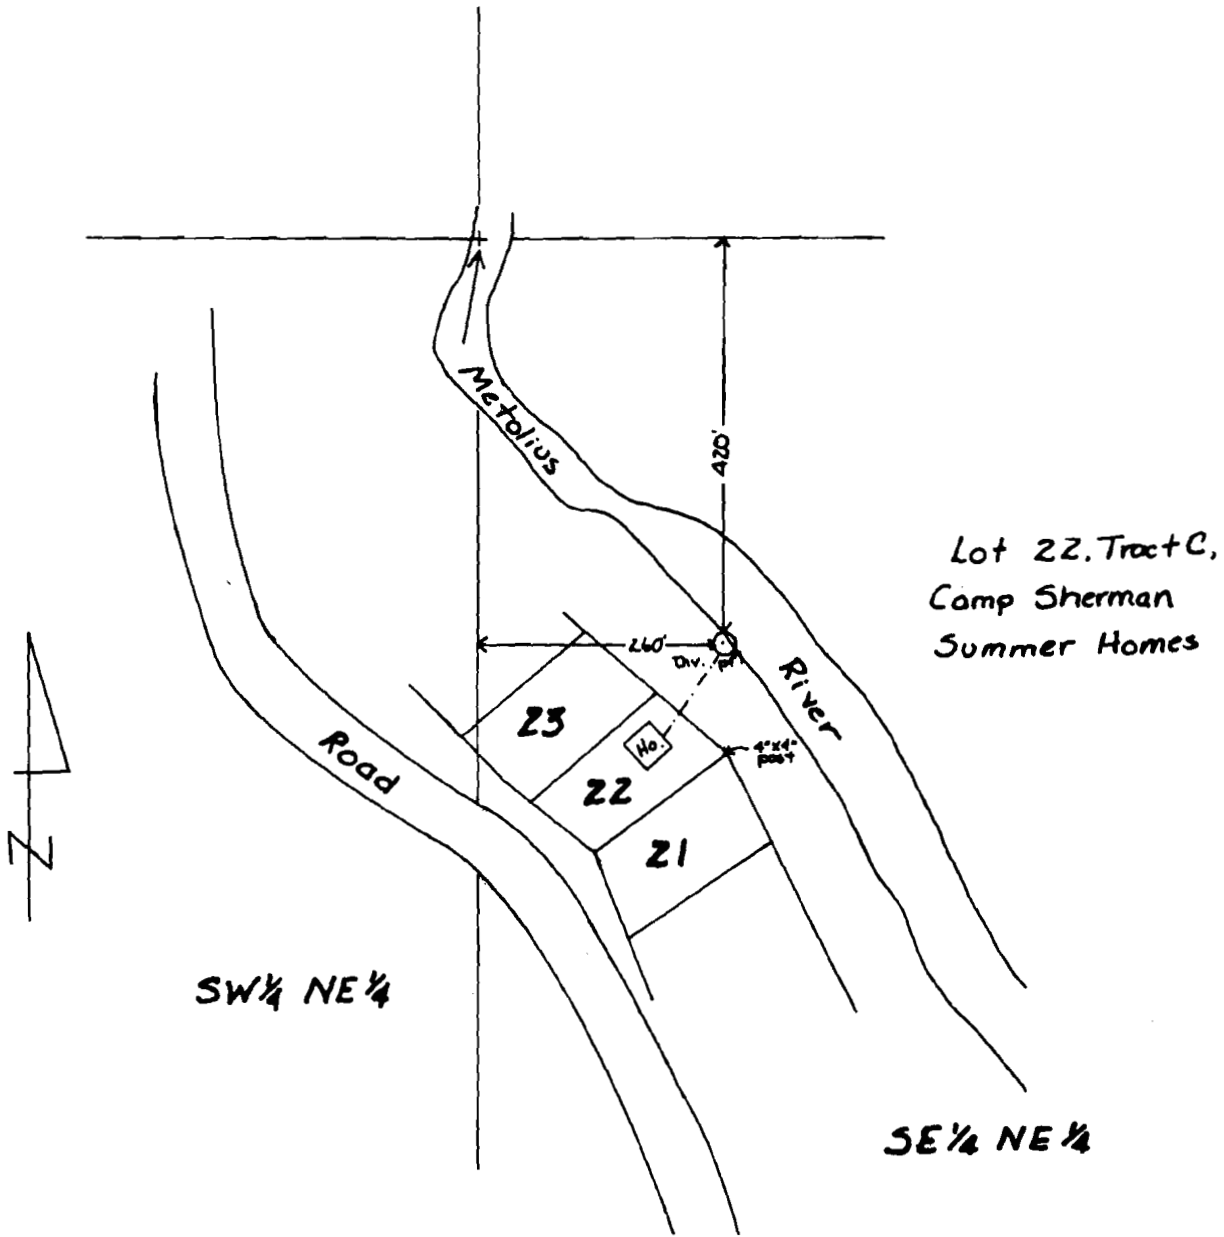

SCALE: 1"=200'

FINAL PROOF SURVEY

UNDER

Application No. 63508 Permit No. 47046

CERT. # 51945

IN NAME OF

JOHN R. & LOIS M. DAVIS

Surveyed OCT. 17, 1983, by D. PANTHER

47046
Chain Survey 240