


T. 13S., R. 9E., W.M.
Section 15

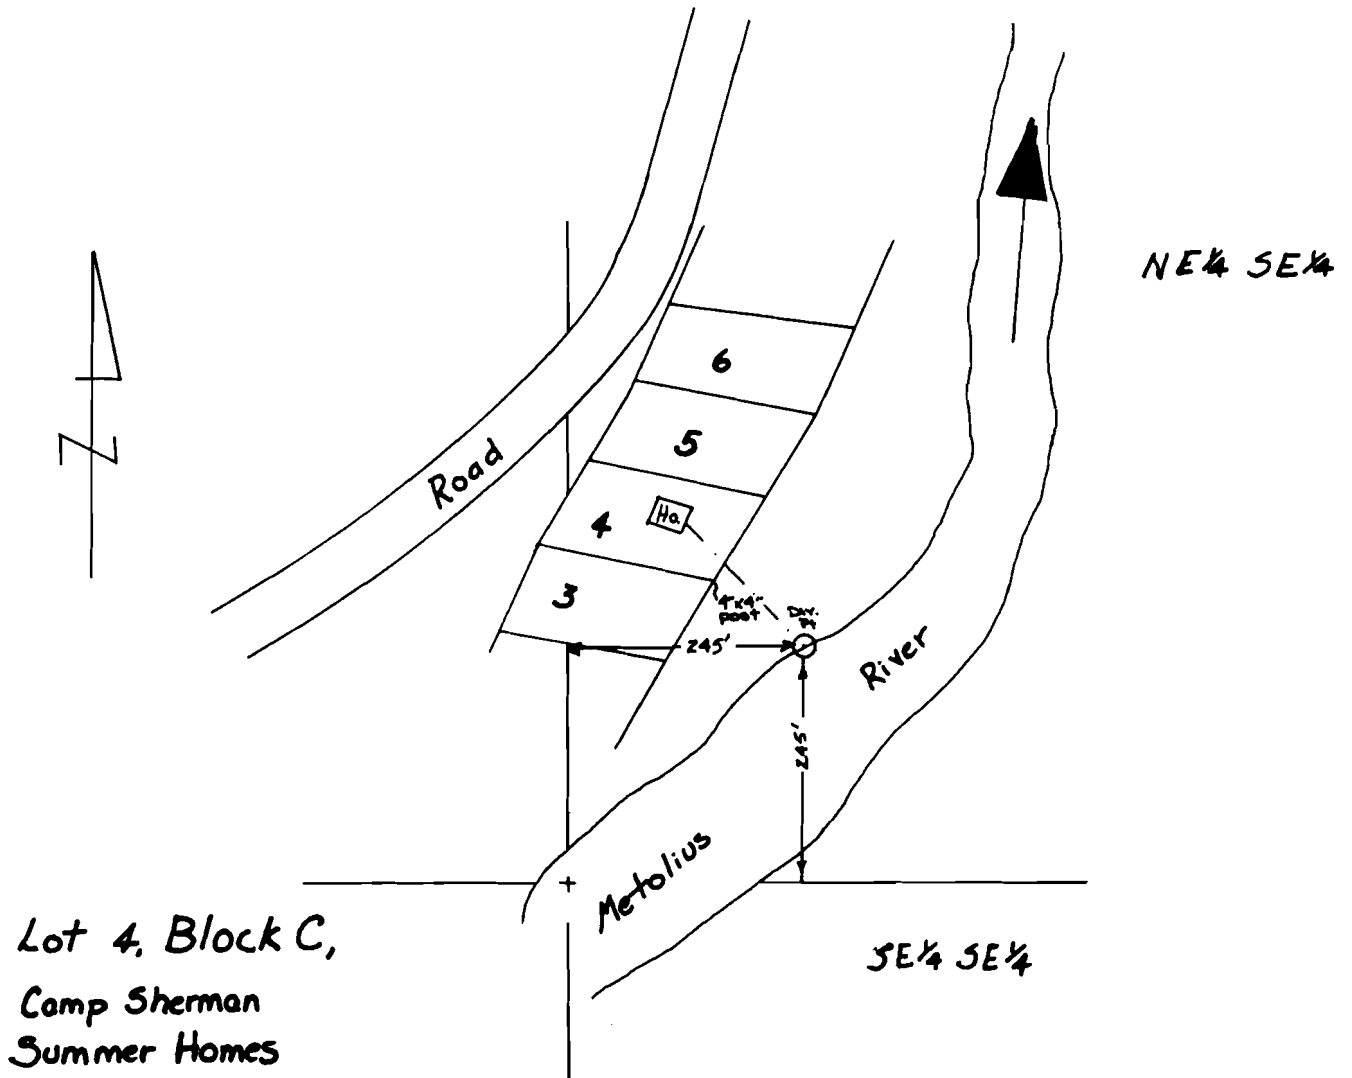

Lot 4, Block C,
Camp Sherman
Summer Homes

SCALE: 1" = 200'

FINAL PROOF SURVEY

UNDER

Application No. 63509 Permit No. 47047 C. 51946

IN NAME OF

HAROLD DENVER PAXTON

Surveyed OCT. 17, 1983, by D. PANTHER

47047
Chain Survey LGO