


T.13S., R.9E., W.M.

Section 15

Lot 9, Tract C,  
Camp Sherman  
Summer Homes

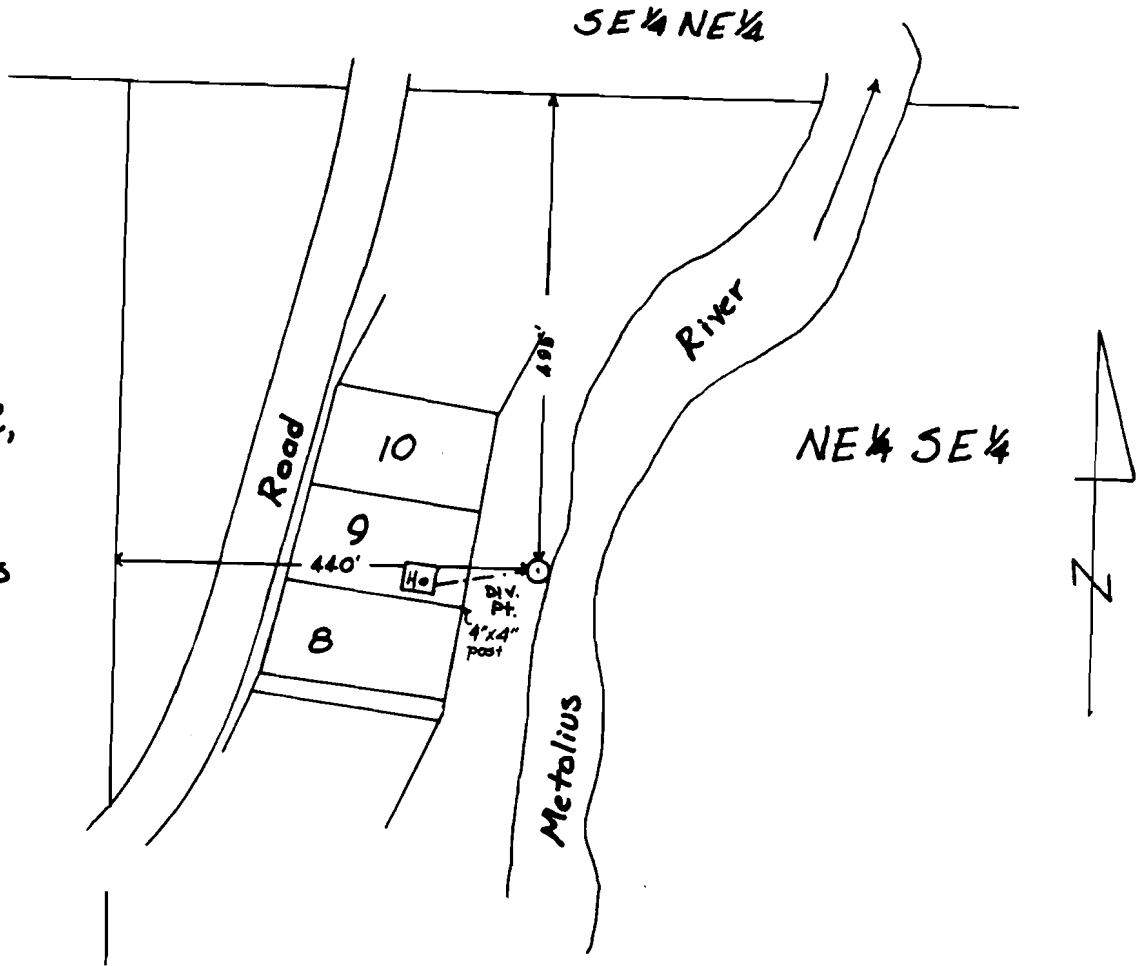

SCALE: 1" = 200'

### FINAL PROOF SURVEY

UNDER

Application No. 63517 Permit No. 47306

Ord. # 51947

IN NAME OF

L. ROBERT & MARTHA HUTCHINS

Surveyed OCT. 17, 1983, by D. PANTHER

47306  
Chain Survey L60