


T.13S., R.9E., W.M.
Section 15

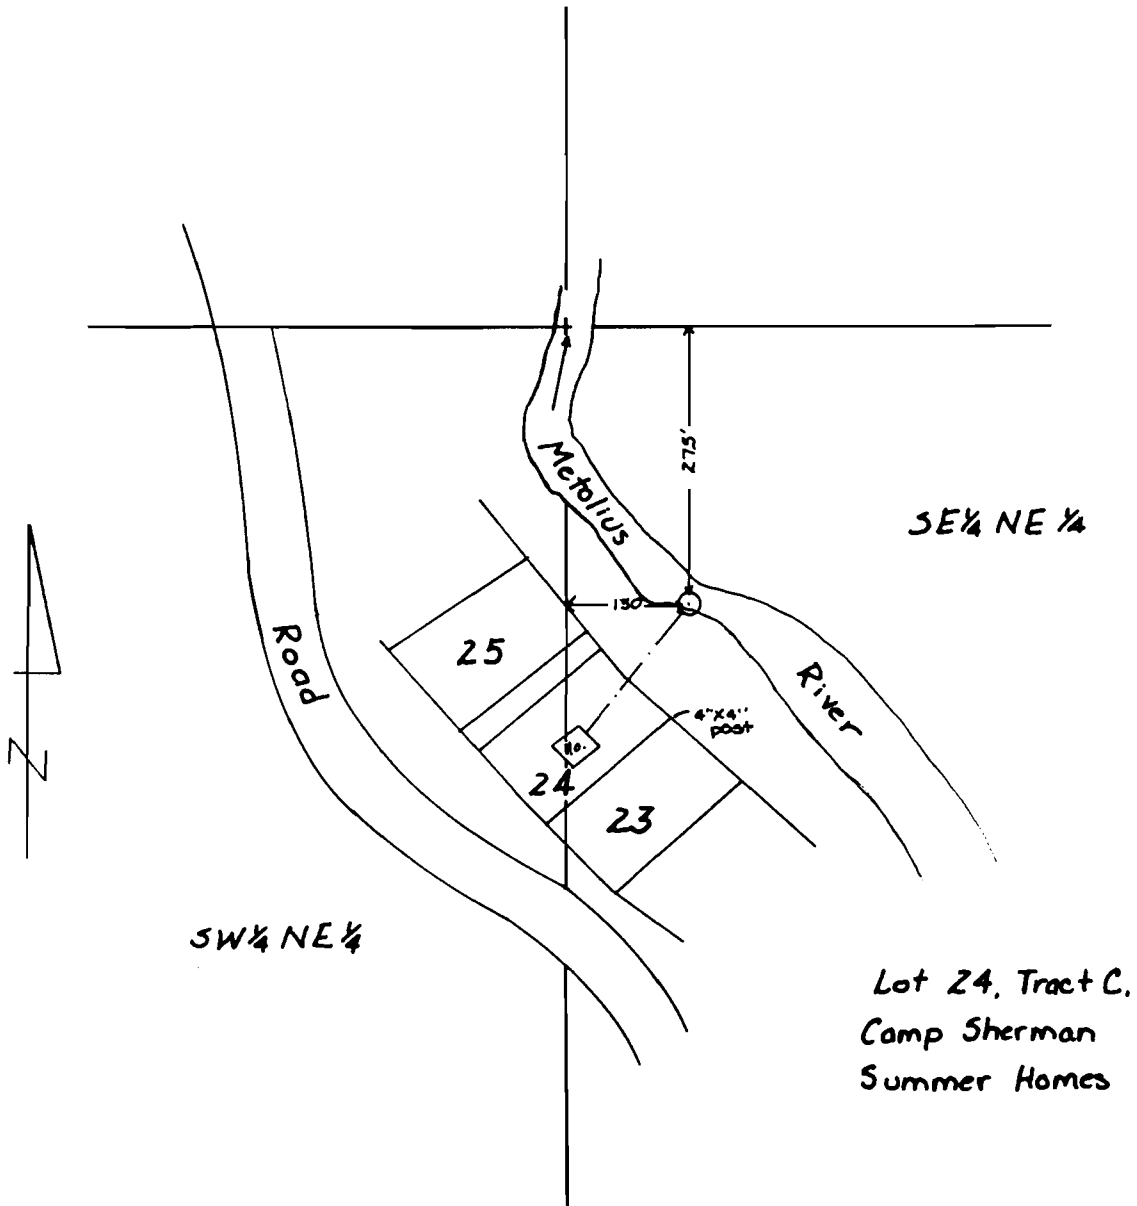

SCALE: 1"=200'

FINAL PROOF SURVEY

UNDER

Application No. 63525, Permit No. 47173

Cart # 51948

IN NAME OF

DAN ALEXANDER

Surveyed OCT. 17, 1983, by D. PANTHER

47173
Chain Survey L60