


T.13S., R. 9E., W.M.
Section 15

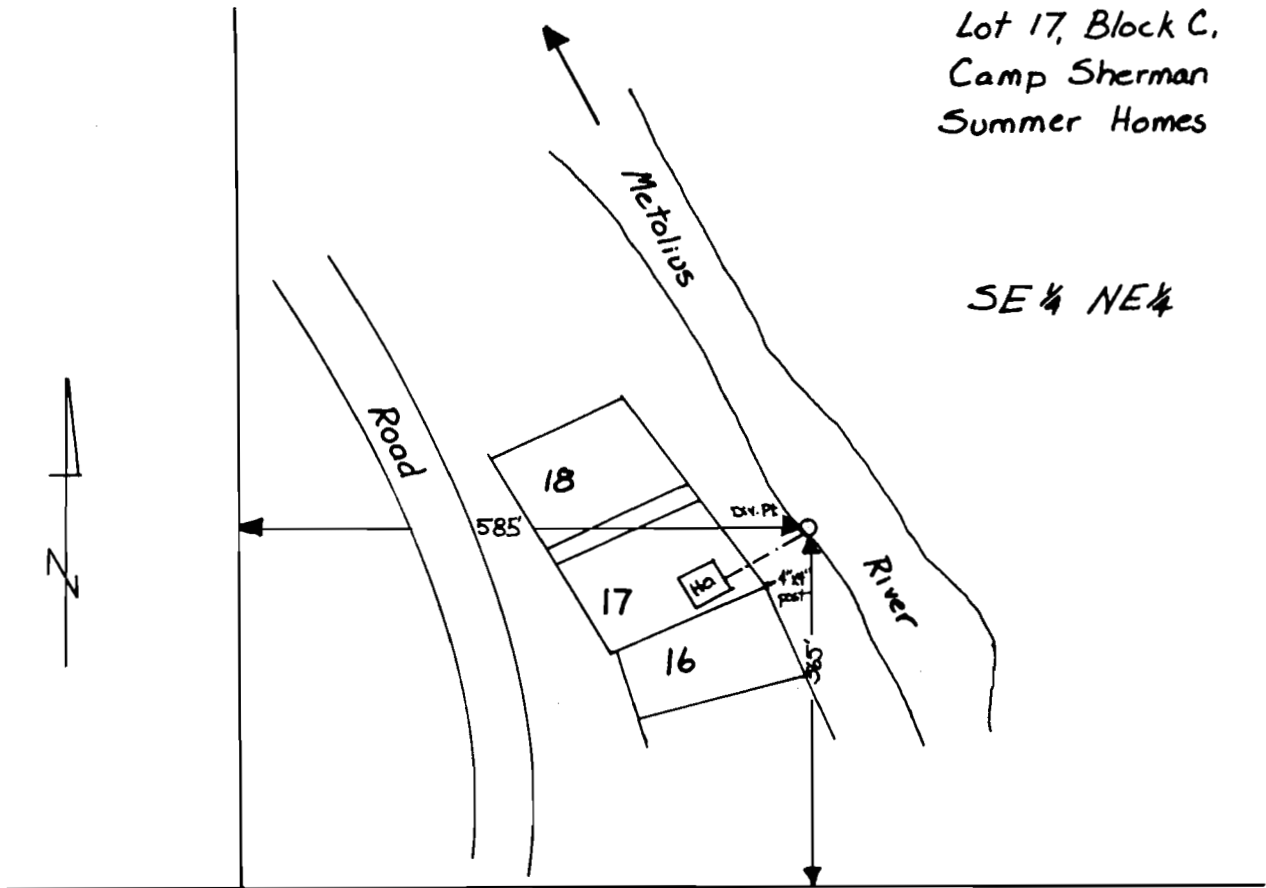

SCALE: 1" = 200'

FINAL PROOF SURVEY

UNDER

Application No. 63540 Serial No. 47152 Cert. # 51949

IN NAME OF

JAMES S. & MARGARET J. FARRA

Surveyed OCT. 17 1983, by D. PANTHER

47152
Chain Survey L60