


T. 135., R. 9E., W.M.

Section 15

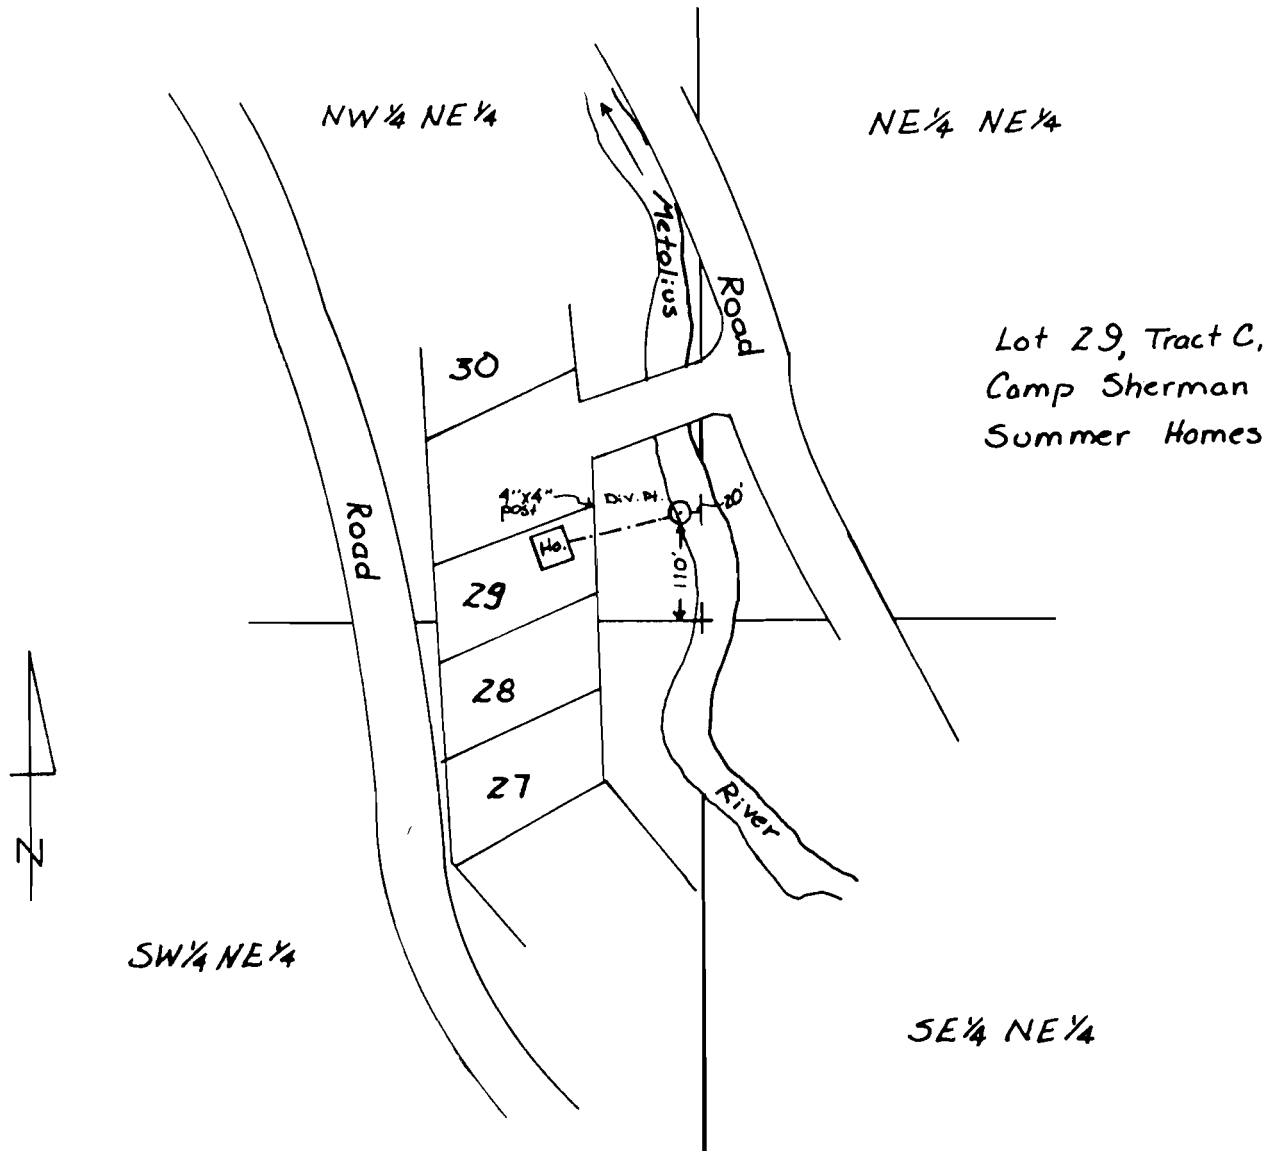

SCALE: 1"=200'

FINAL PROOF SURVEY

UNDER

Application No. 63712 Permit No. 47211

IN NAME OF

EARL A. & MARY E. RICHARDS

Surveyed OCT. 17, 1983, by L. OLSON