


T.13S., R.9E., W.M.
Section 15

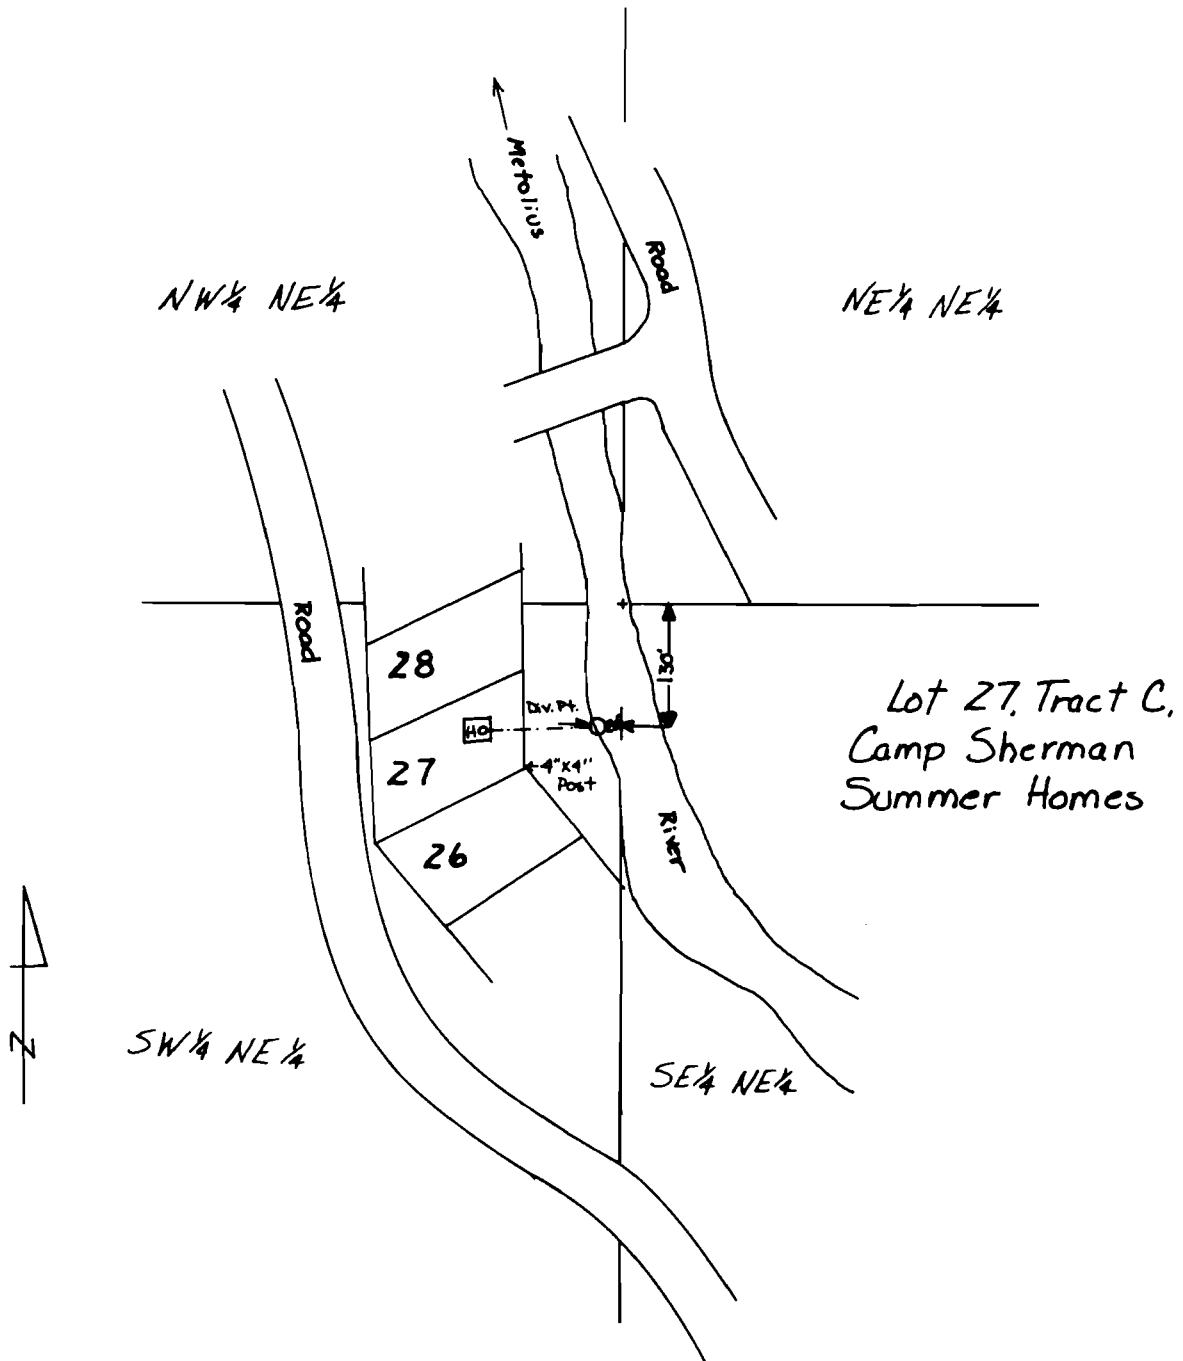

SCALE: 1"=200'

FINAL PROOF SURVEY
UNDER

Application No. 63775 Permit No. 46926 Cert. # 51952

IN NAME OF

DARREL L. GUTZLER

Surveyed OCT. 17, 1983, by L. OLSON

Chain Survey 46926