


T.13S., R.9E., W.M.  
Section 15

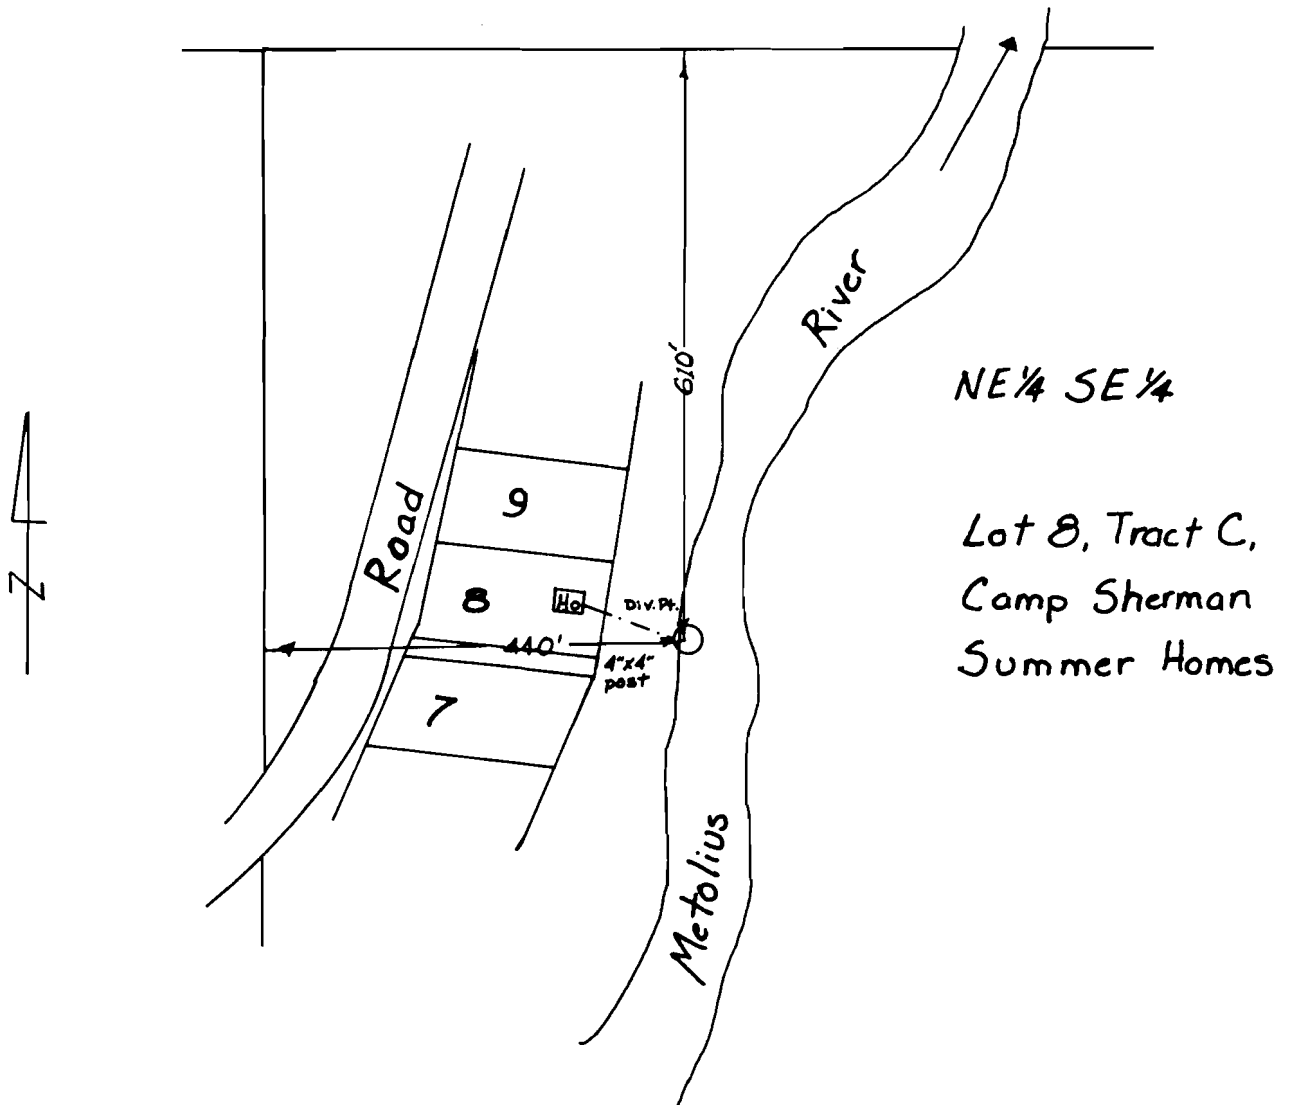

SCALE: 1"=200'

**FINAL PROOF SURVEY**  
UNDER

Application No. 63779 Permit No. 47259

C. 51953

IN NAME OF

KENNETH T. LAMEAR

Surveyed OCT. 17, 1983, by D. PANTHER

47259  
Chain Survey 1980