


T. 13 S., R. 9 E., W. M.
Section 15

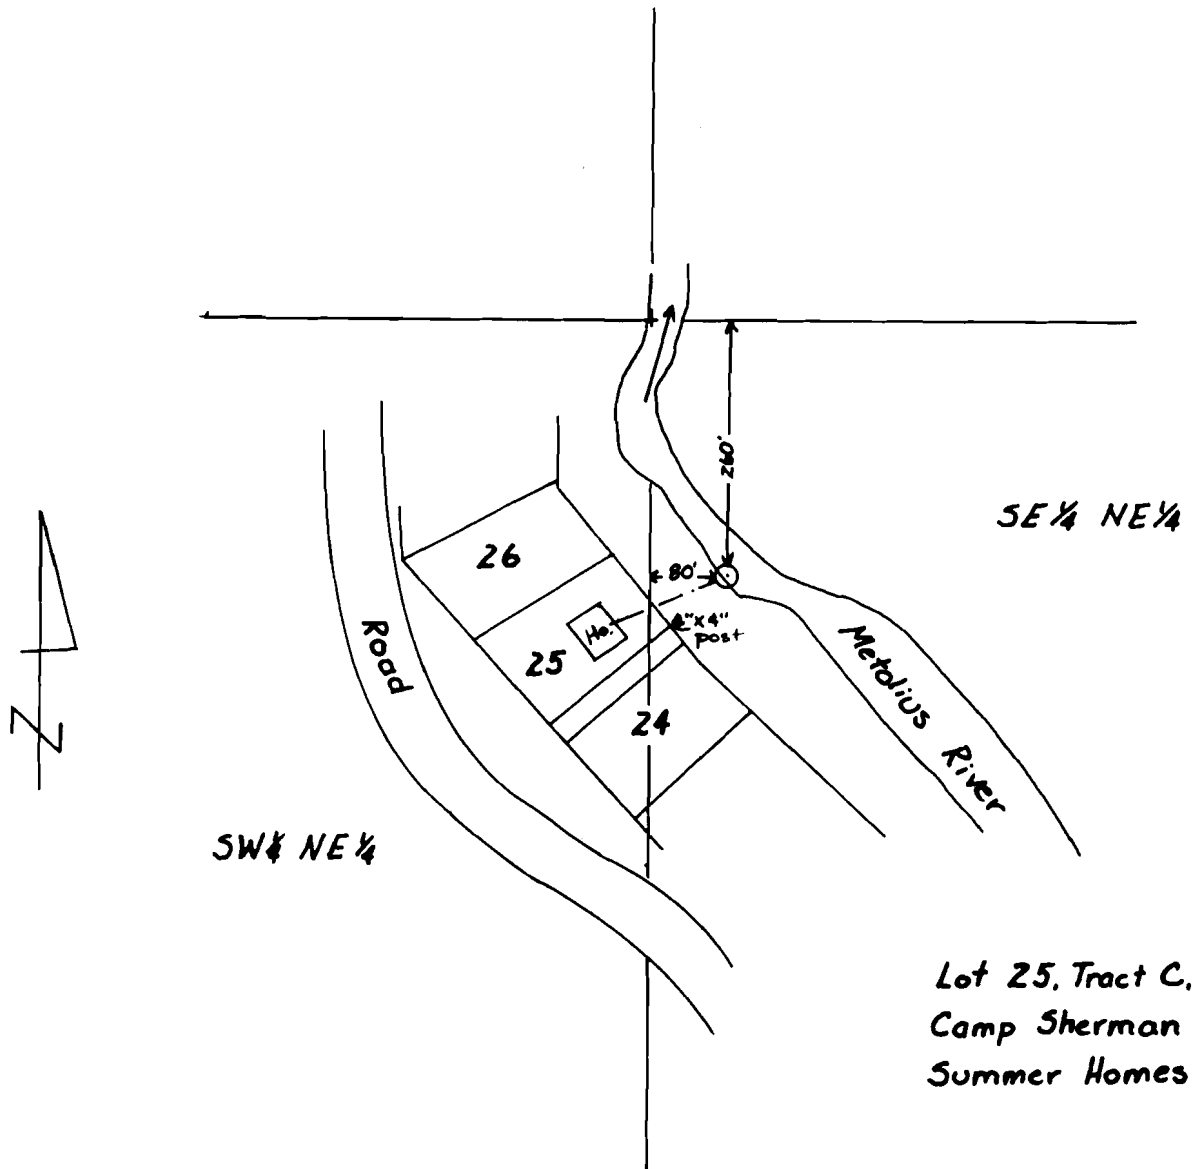

SCALE: 1" = 200'

FINAL PROOF SURVEY

UNDER

Application No. 64052 Permit No. 47099 Ctr. # 51954

IN NAME OF

E.M. &/or KATHRYN GRIFFIN

Surveyed OCT. 17, 1983, by D. PANTHER

47099
Chain Survey L&O