


T. 13 S., R. 9 E., W. M.
Section 3

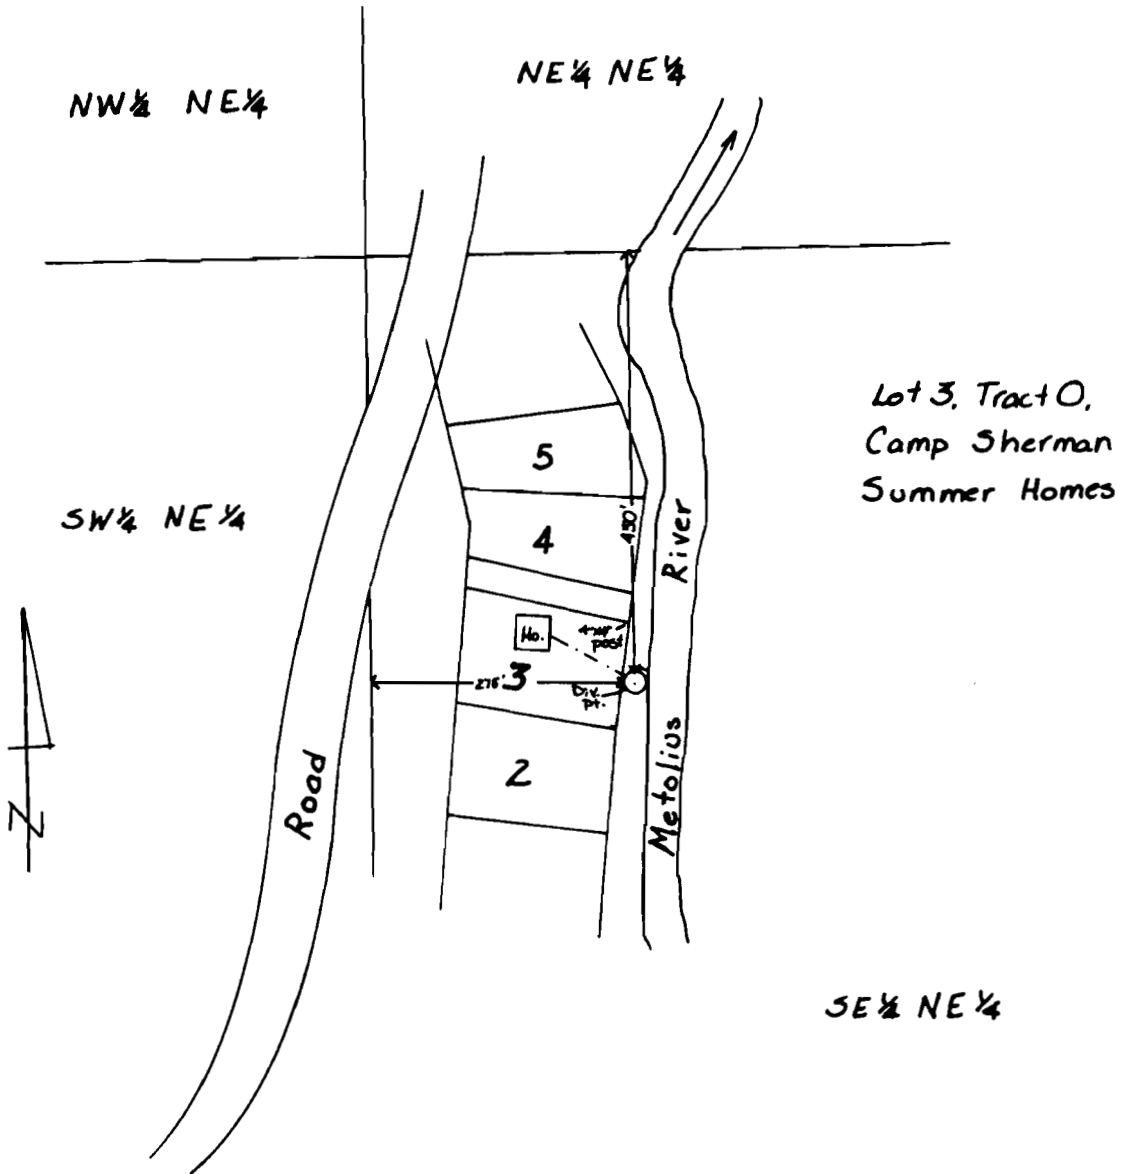

SCALE: 1" = 200'

FINAL PROOF SURVEY

UNDER

Application No. 64182 File # No. 47265 CERT. # 51955

IN BEHALF OF

DONALD J. & CAROL A. DeFRANCO

Surveyed OCT. 17, 1983, by D. PANTHER

47265
Chain Survey L&C