


T.13 S., R.9 E., W.M.

Section 15

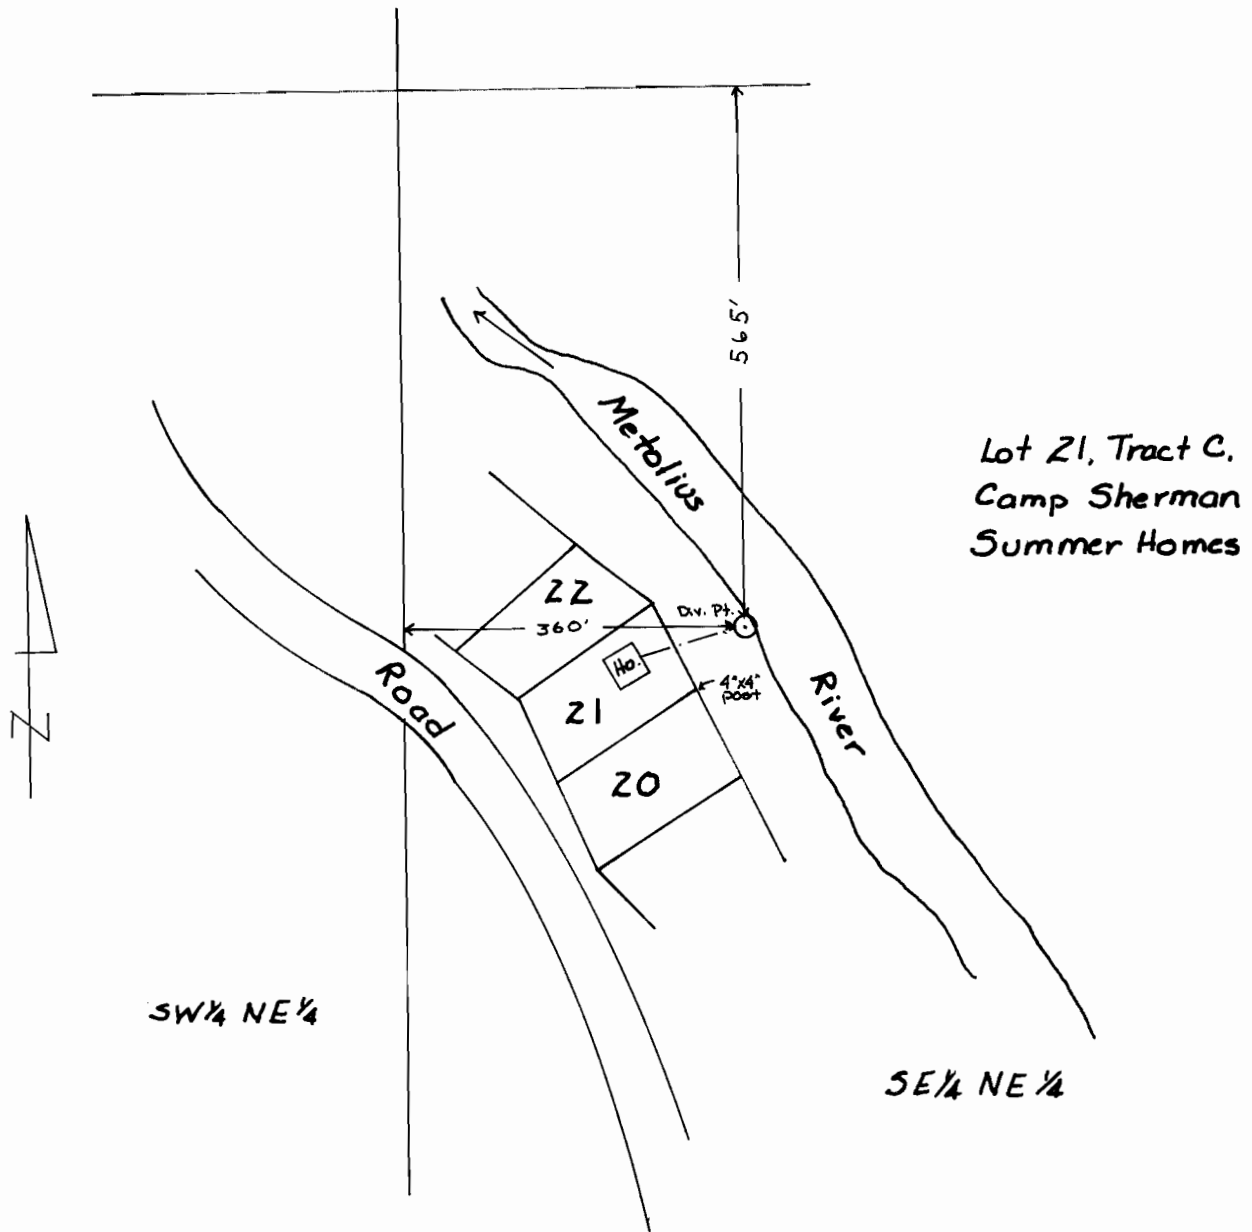

SCALE: 1"=200'

# FINAL PROOF SURVEY

UNDER

Application No. 64421 Permit No. 47142

IN NAME OF

TORLEF NELSON

Surveyed OCT. 17, 1983, by D. PANTHER