


T.13S., R.9E., W.M.

Section 15

Lot 40, Tract C,
Camp Sherman
Summer Homes

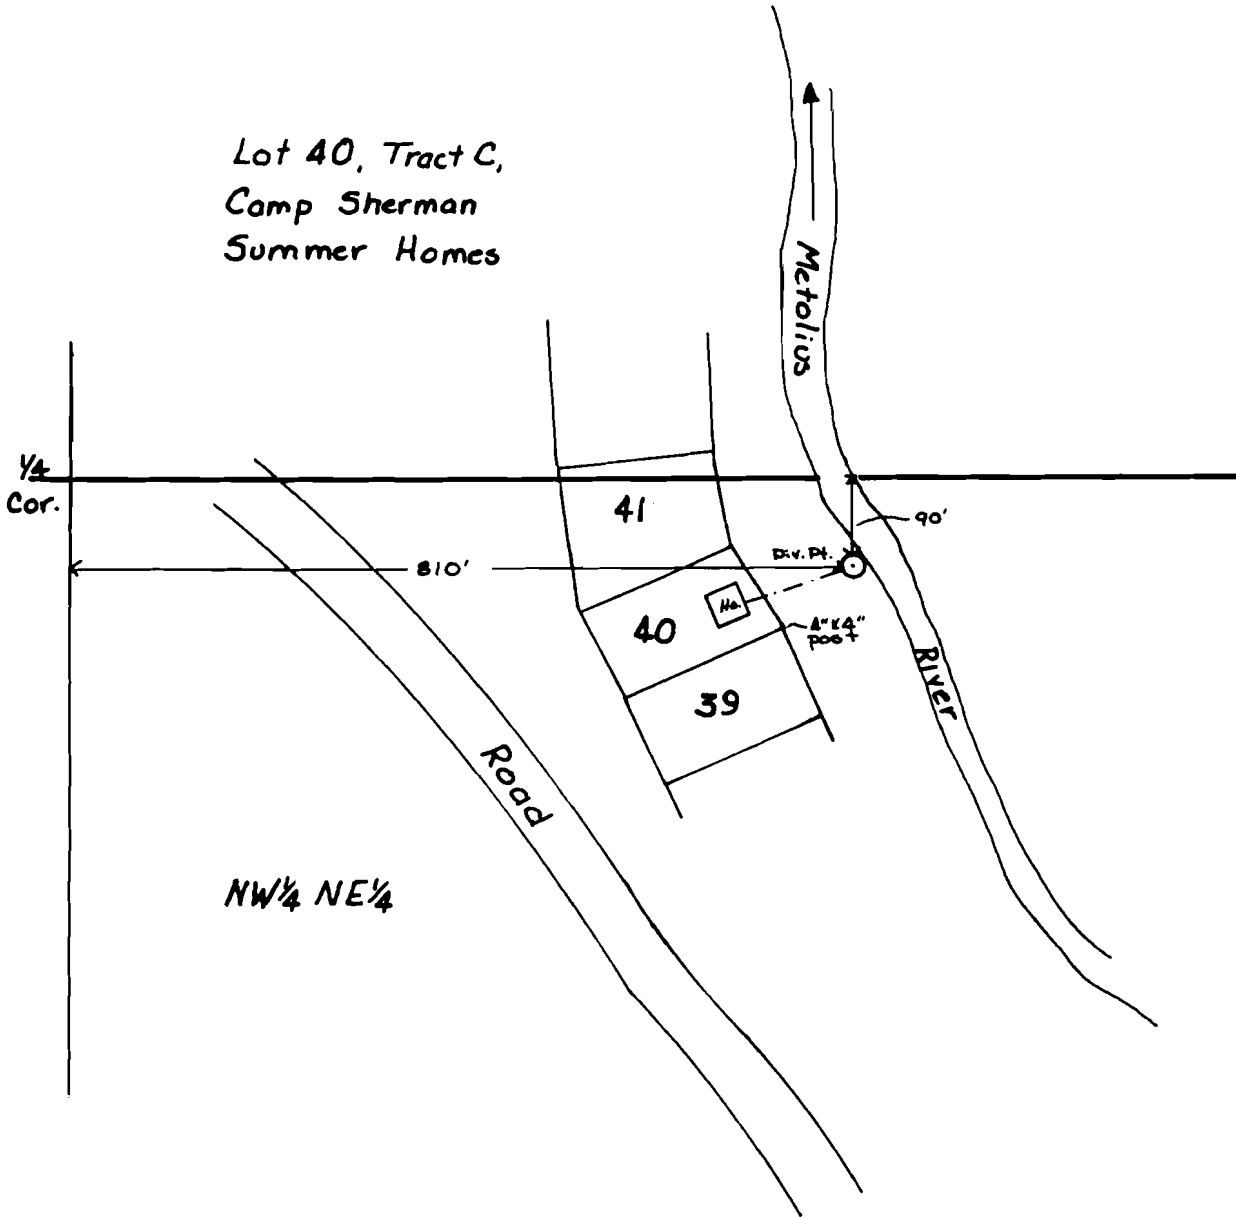

SCALE: 1" = 200'

FINAL PROOF SURVEY

UNDER

Application No. 63552 Permit No. 47205

IN NAME OF

JOHN & IRMA PARKEY C. 51957

Surveyed OCT. 17, 1983, by B. ESTES

47205
Chain Survey L40