


T.13S., R.9E., W.M.
Section 3

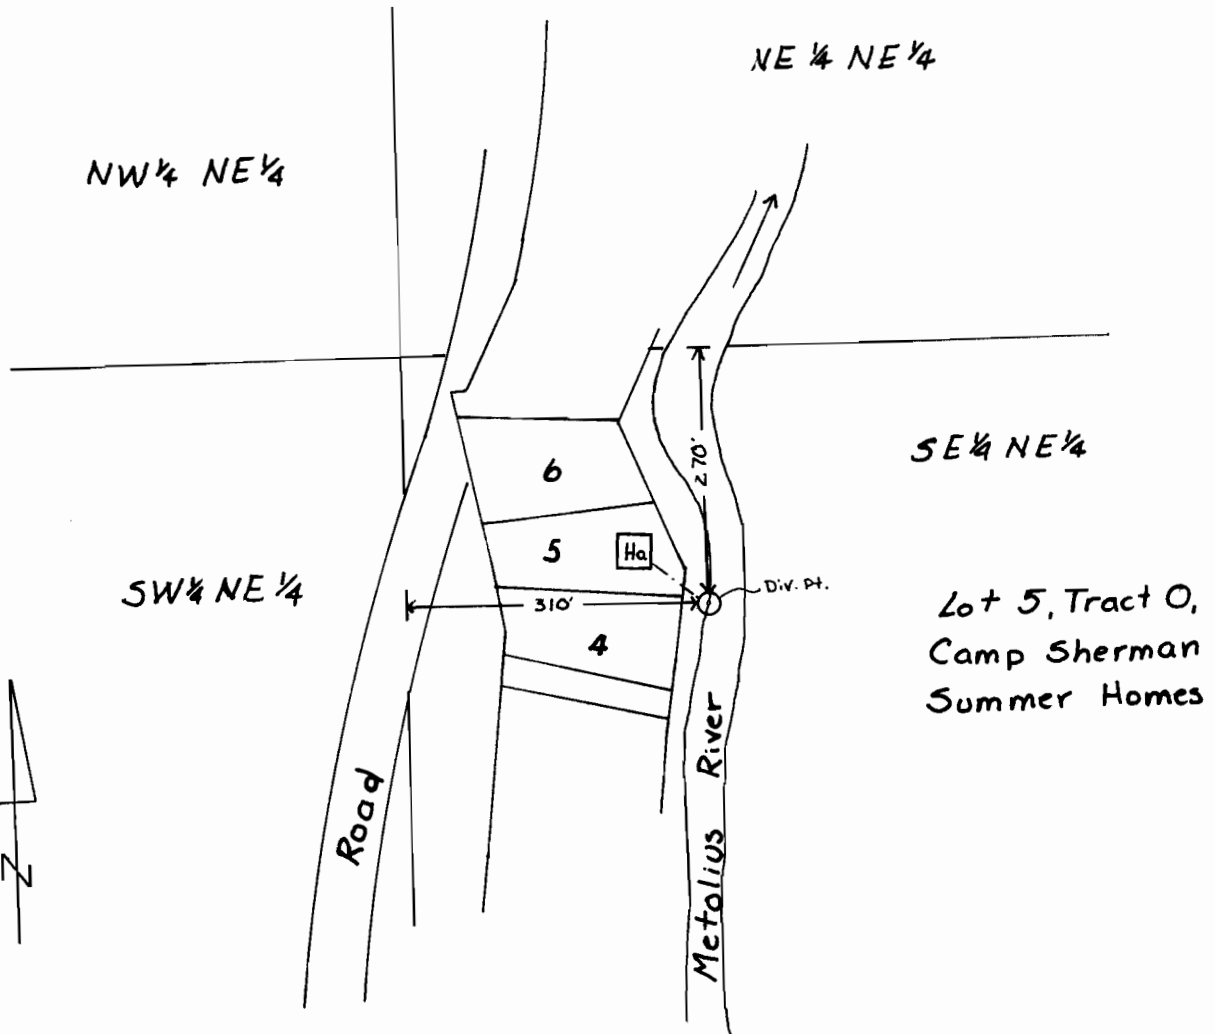

05/12/83
1983
Michael H. Graham
D. Panther

SCALE: 1"=200'

FINAL PROOF SURVEY

UNDER

Application No. 64553 Permit No. 47541

IN NAME OF

MICHAEL H. GRAHAM

Surveyed OCT. 17, 1983, by D. PANTHER