


T. 13S., R. 9E., W.M.  
Section 15

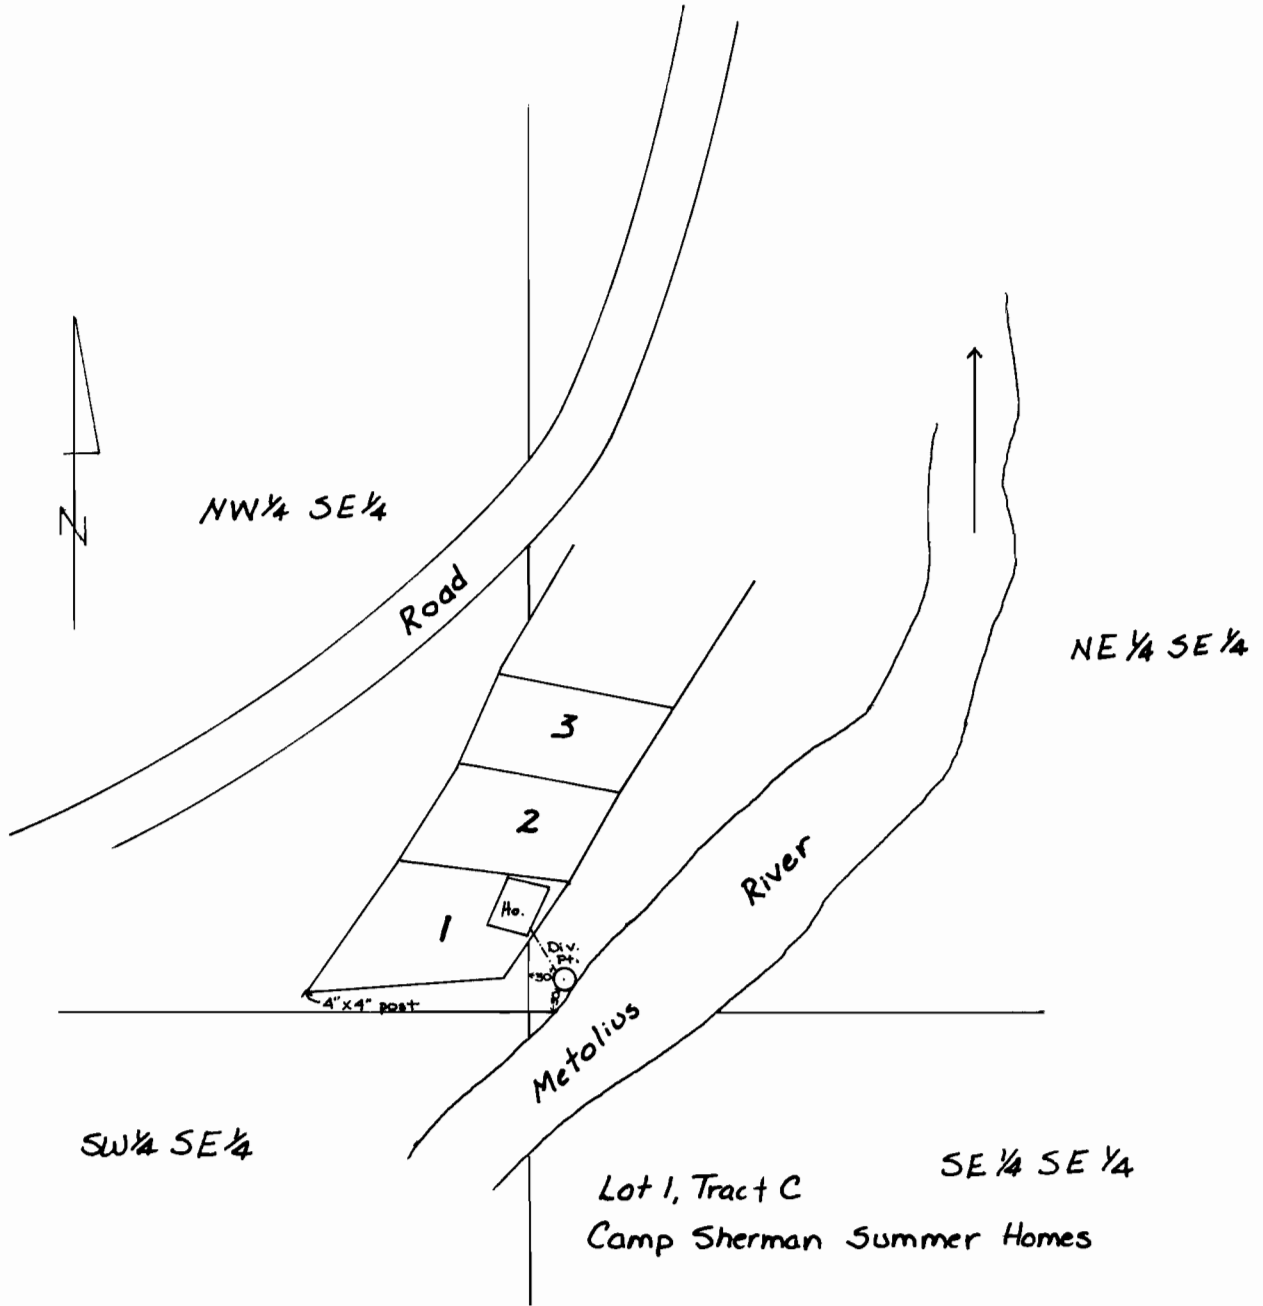

SCALE: 1"=200'

**FINAL PROOF SURVEY**

UNDER

Application No. 64571.. Permit No. 47434.....

IN NAME OF

TERESA C. MILLAR.....

Surveyed OCT. 17.. 1983., by D. PANTHER.....