


T. 28 S. R. 14 W. W. M.

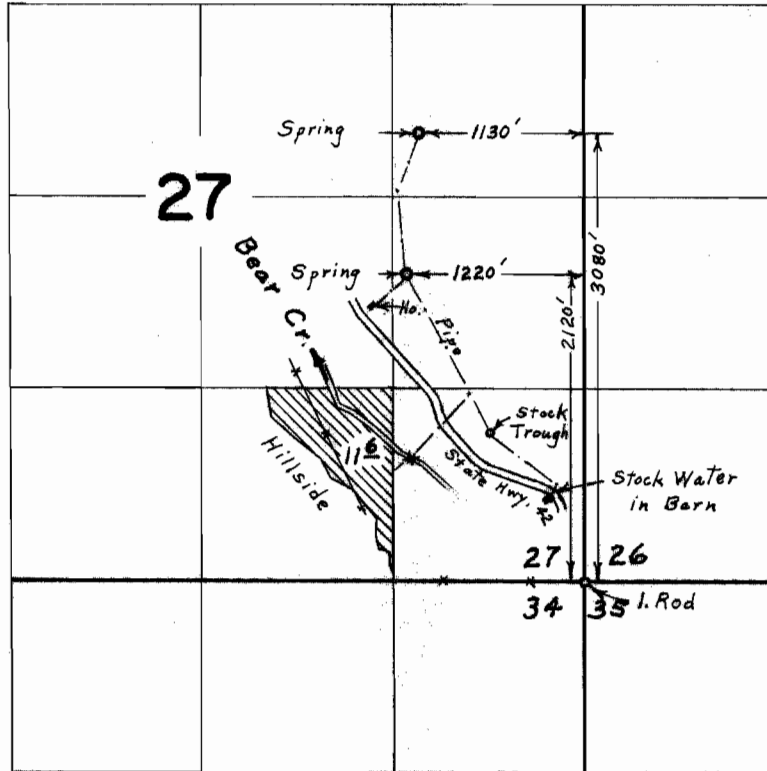

**FINAL PROOF SURVEY**  
UNDER

Application No. 34082. Permit No. 28690.  
IN NAME OF

**GLADYS O. PHILPOTT**

Surveyed July 19, 1968, by L. E. Gould