T.26S.R.6W.W.M.

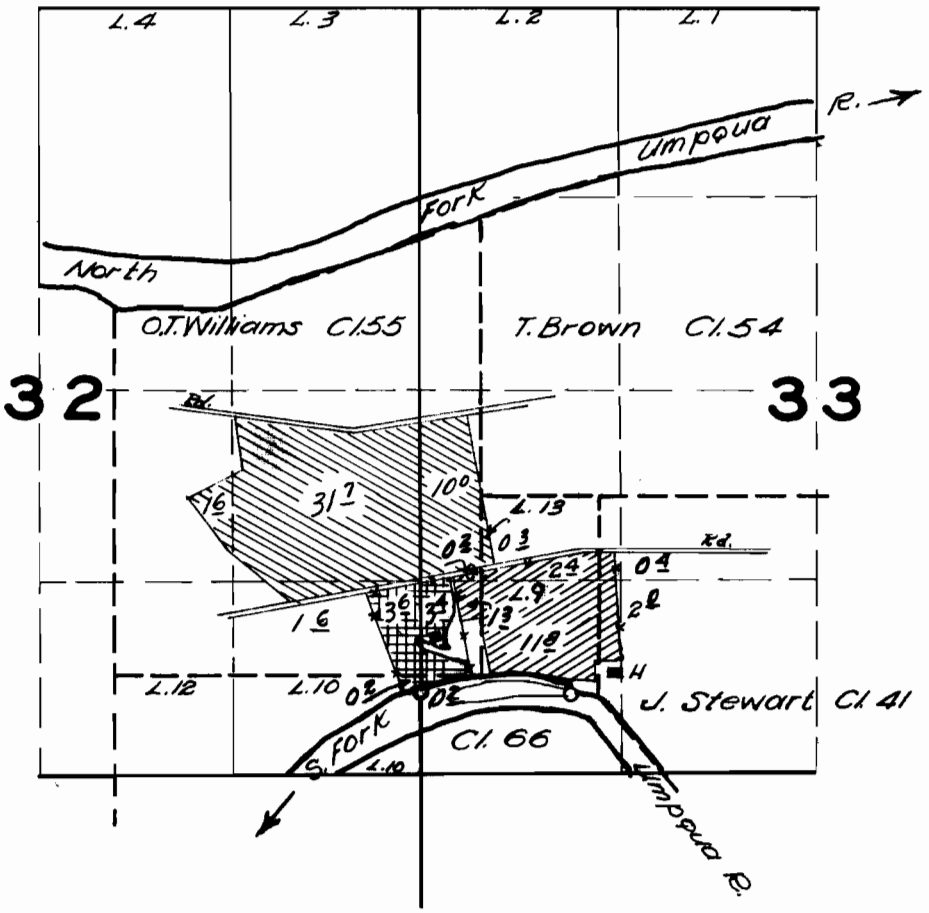

FINAL PROOF SURVEY

UNDER

Application No. 26333 27183 Permit No. 20663 21379

IN NAME OF

W. H. Carter

M. B. Emmitt & H. B. Kruse

Surveyed July 21 1954, by H. L. Coffman

27183	Kruse	31 7
27183	Emmitt	36
26333	Carter	11 2

Db-Hw-17-20
Pantograph