


T. 24 S., R. 7 W., W. M.

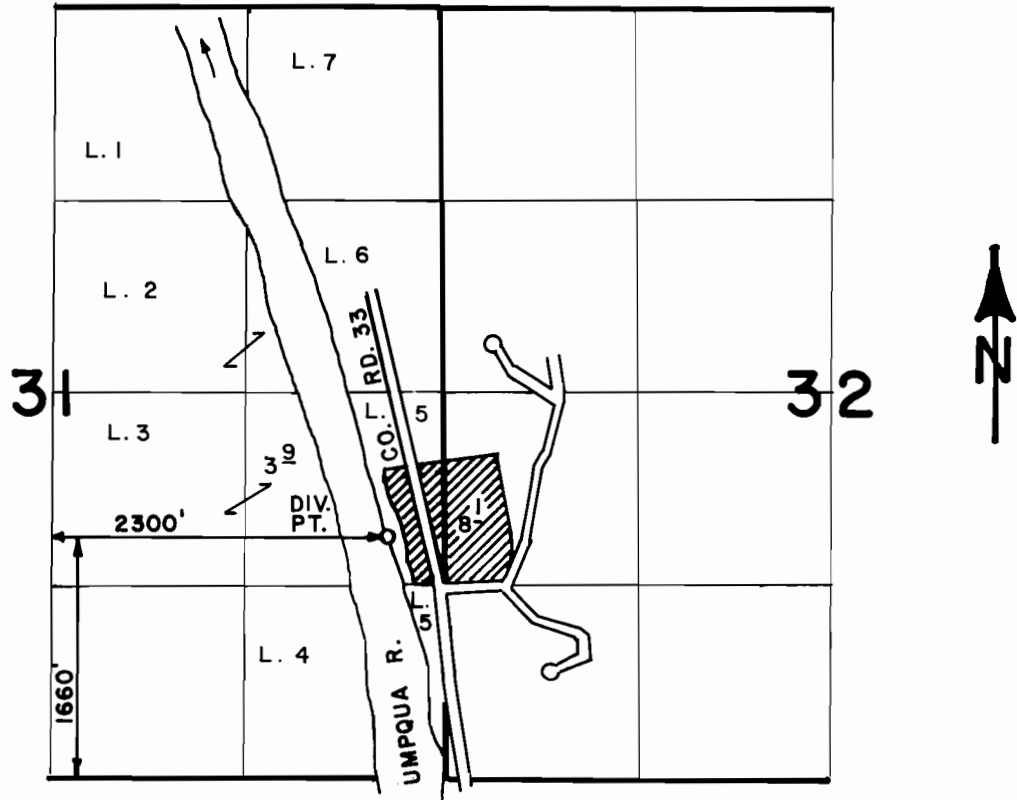

SCALE: 4" = 1 MILE

FINAL PROOF SURVEY UNDER

Application No. 49090... Permit No. 36825.....
IN NAME OF

.....ROY W. STEPHENSON.....

Surveyed JUNE 5... 1975, by L. E. GOULD.....