


T. 26 & 27S., R. 6 W., W.M.

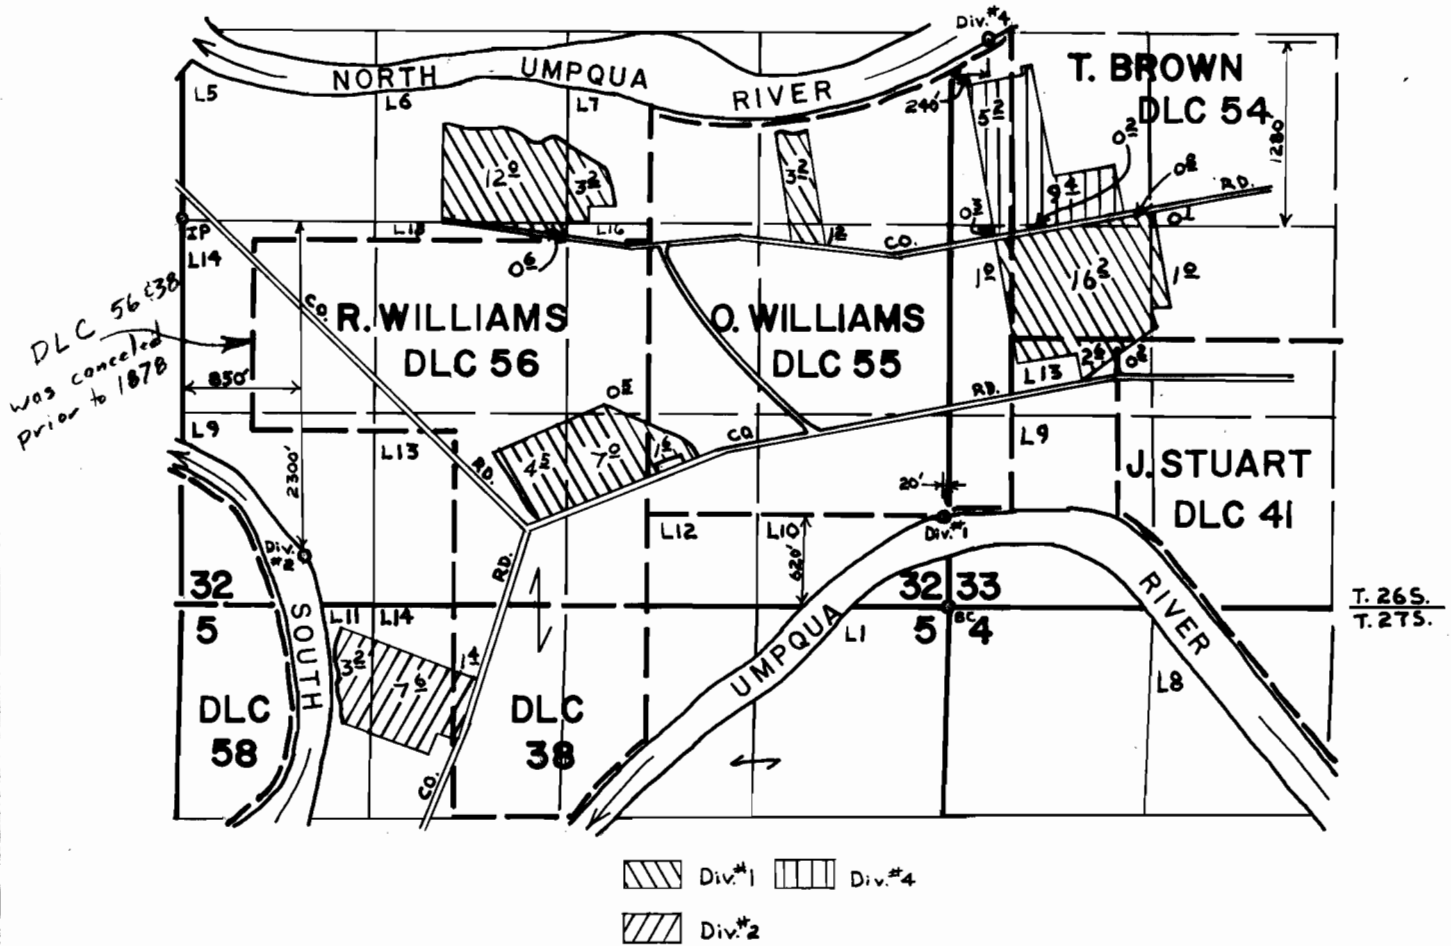

FINAL PROOF SURVEY UNDER

Application No. 49182 Permit No. 36869
 IN NAME OF
DON KRUSE

Surveyed MAY 3 1978, by D.W. SPARKS