


T.8S. R.3W., W.M.

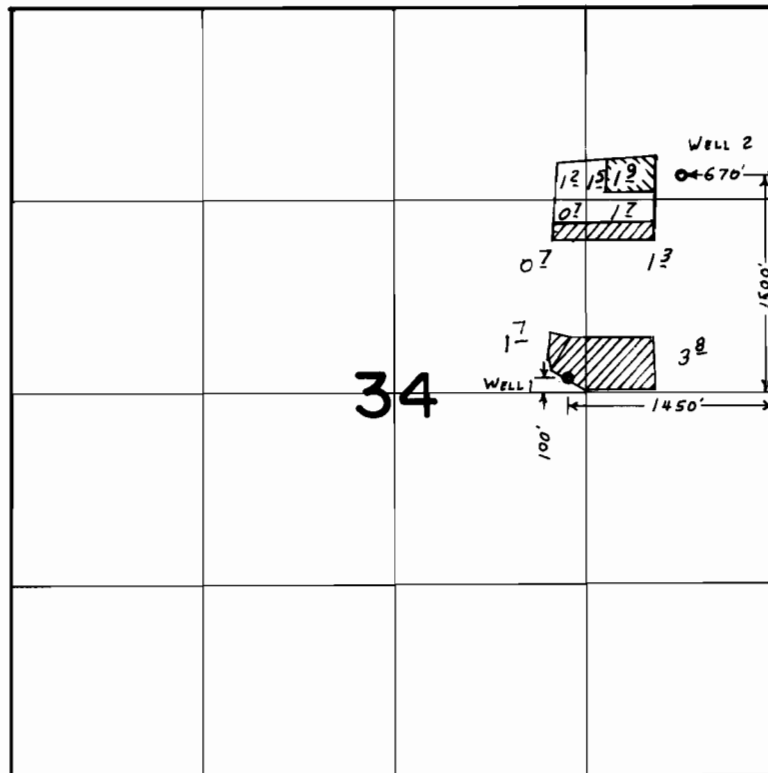

WELL 1
WELL 2

FINAL PROOF SURVEY
UNDER

Application No. G-7817... Permit No. G-7226.....
IN NAME OF

DONALD BERNARDS

Surveyed MAY 15, 1979, by L. H. NUNN