


Per # 9628  
51971  
10659

TOWNSHIP 10S, RANGE 30E, W. M.

North

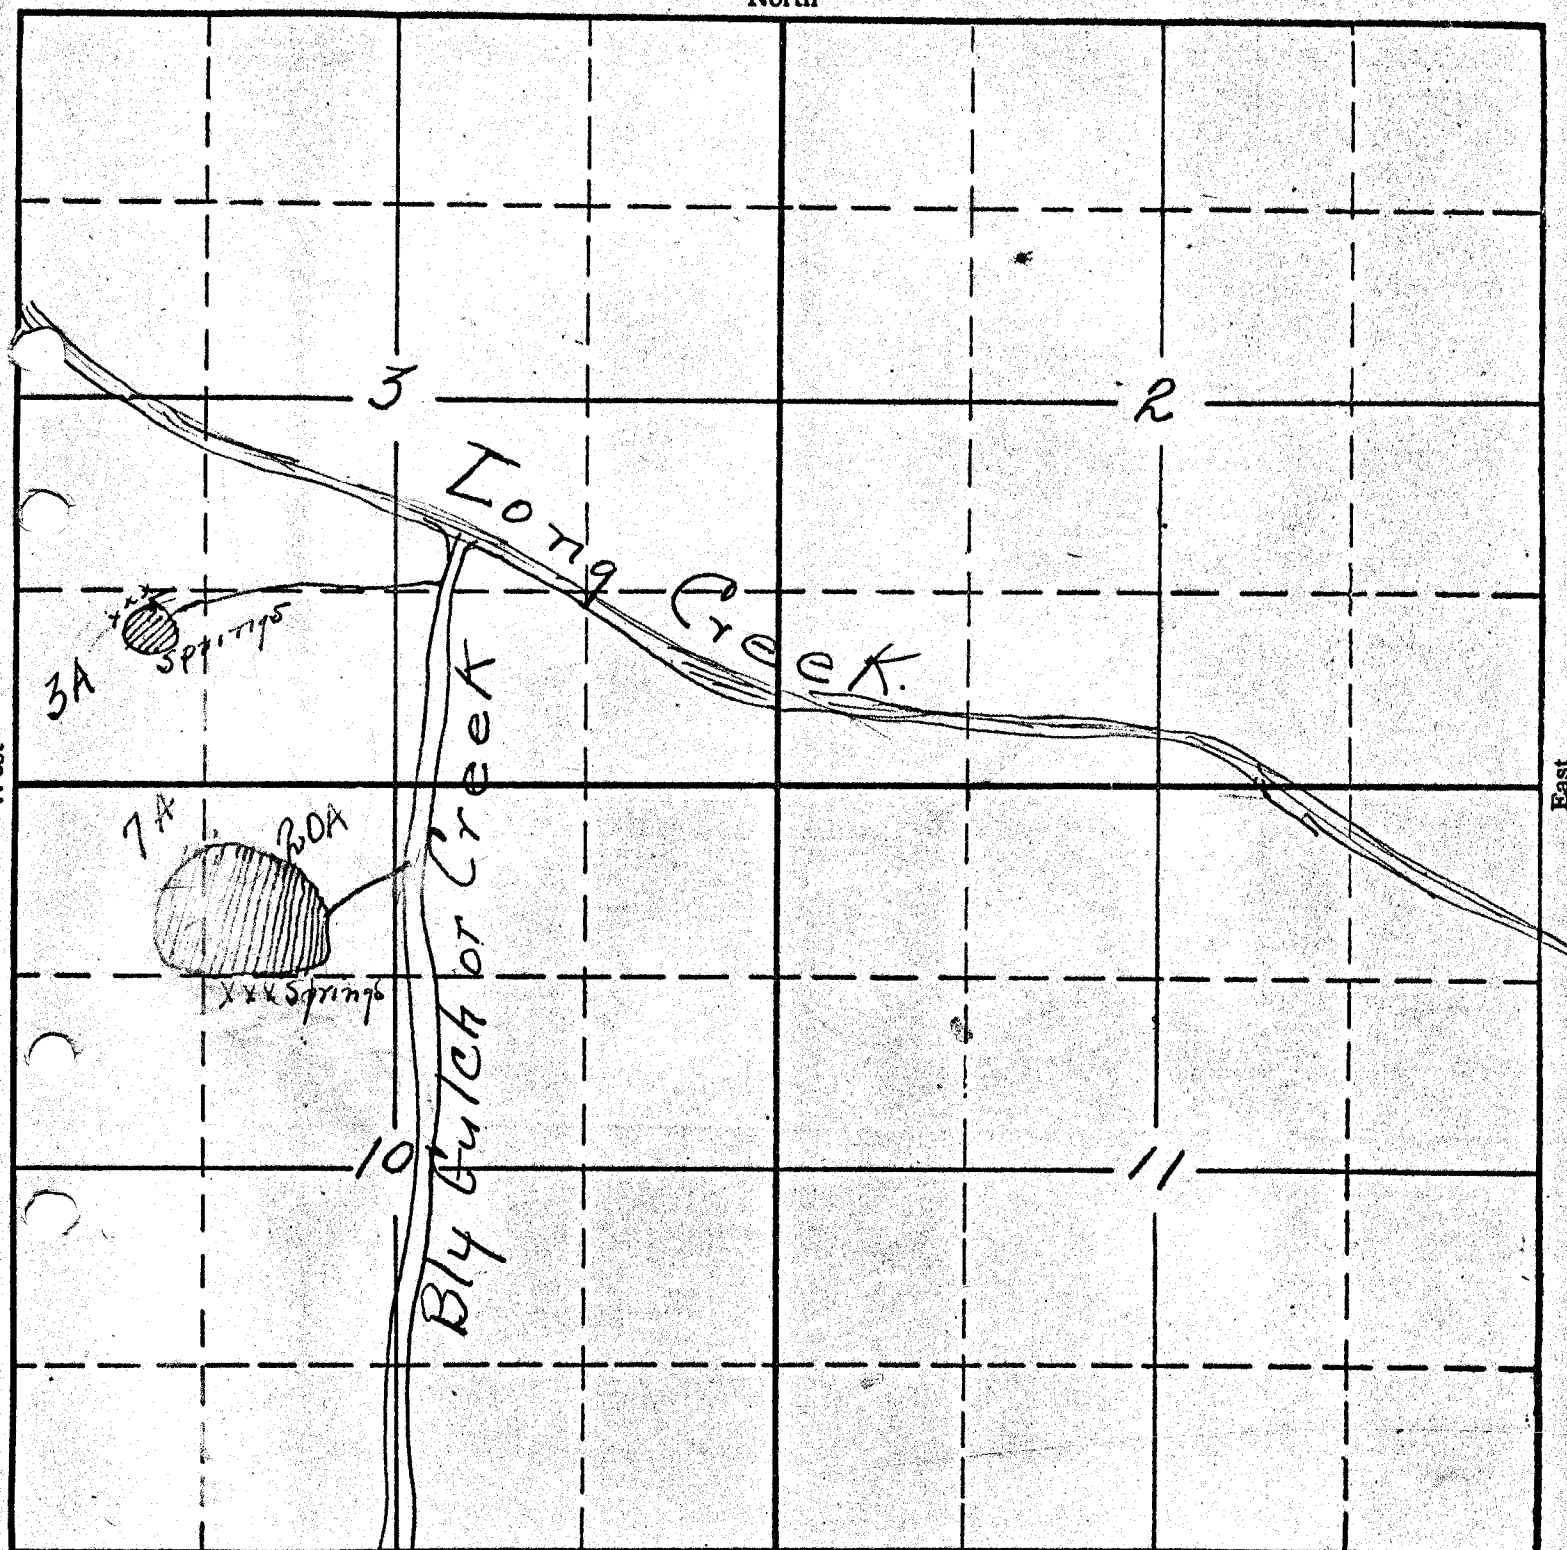

South

RECEIVED  
JUN 24 1936  
STATE ENGINEER  
SALEM, OREGON

6-26-  
APPLICATION No. 13419  
PERMIT No. 9628