


T.36S., R.2E., W.M.

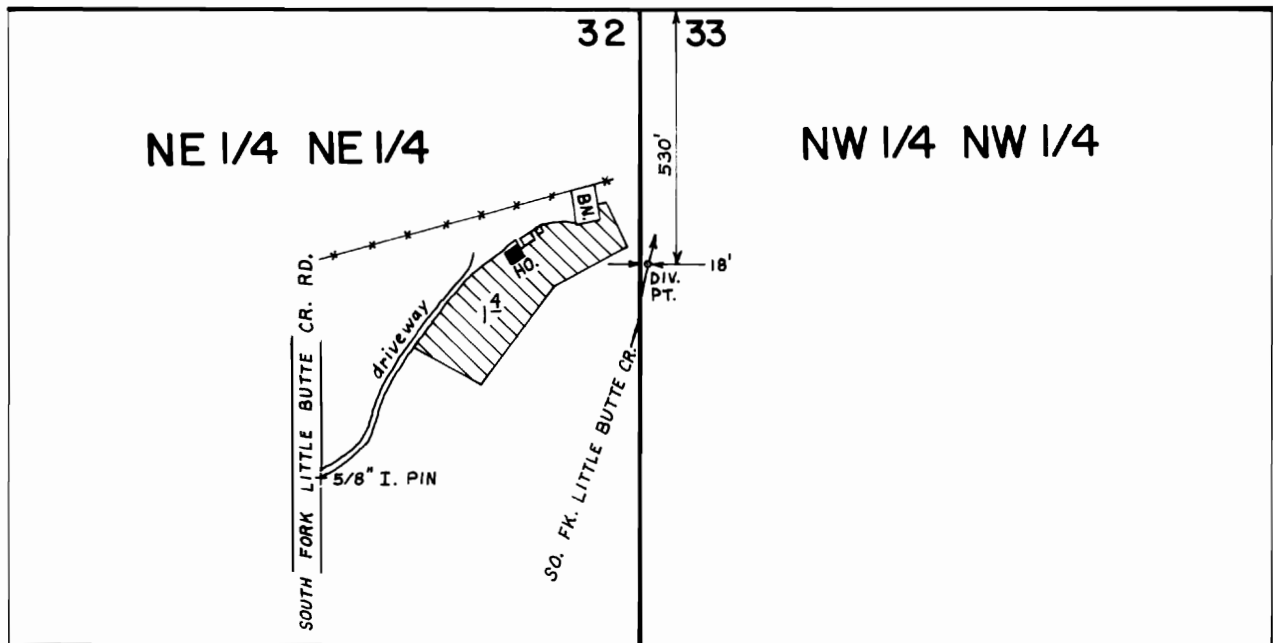

SCALE: 1" = 400'

FINAL PROOF SURVEY UNDER

TRANSFER NO. 4014

Application No. Permit No.
IN NAME OF

GEORGE T. &/or ELSIE N. McDONALD..

Surveyed JULY 29 1982, by BRUCE R. SUND.