


T. 17S. R. 11W. WM

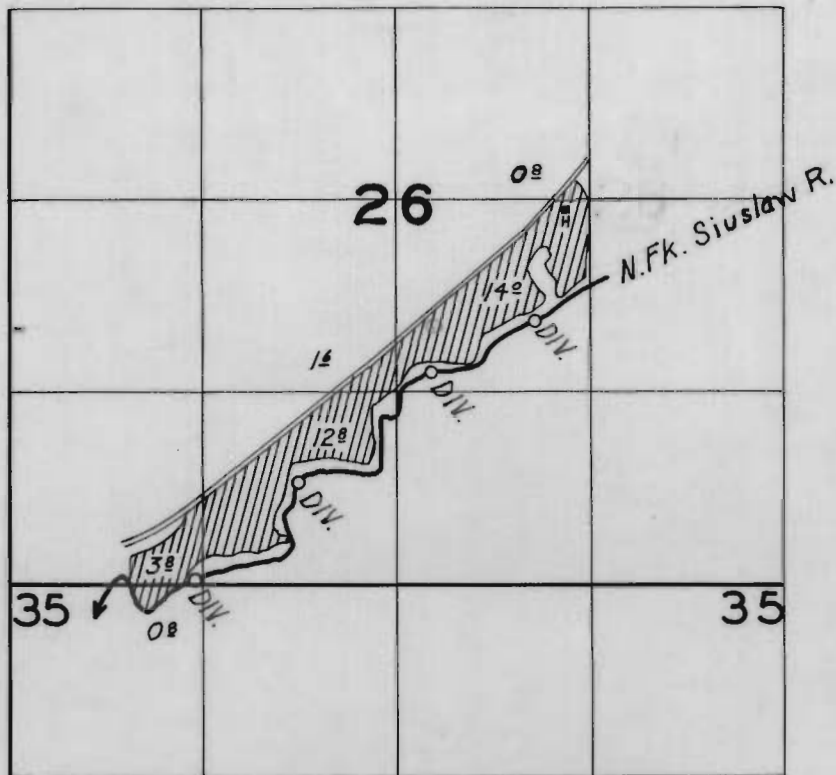

**FINAL PROOF SURVEY**

UNDER

Application No. 23188..... Permit No. 18422.....

IN NAME OF

V. E. Dwyer

Surveyed Aug. 13 1954, by T. Jones.....