


T. 16 S. R. 2 E. W. M.

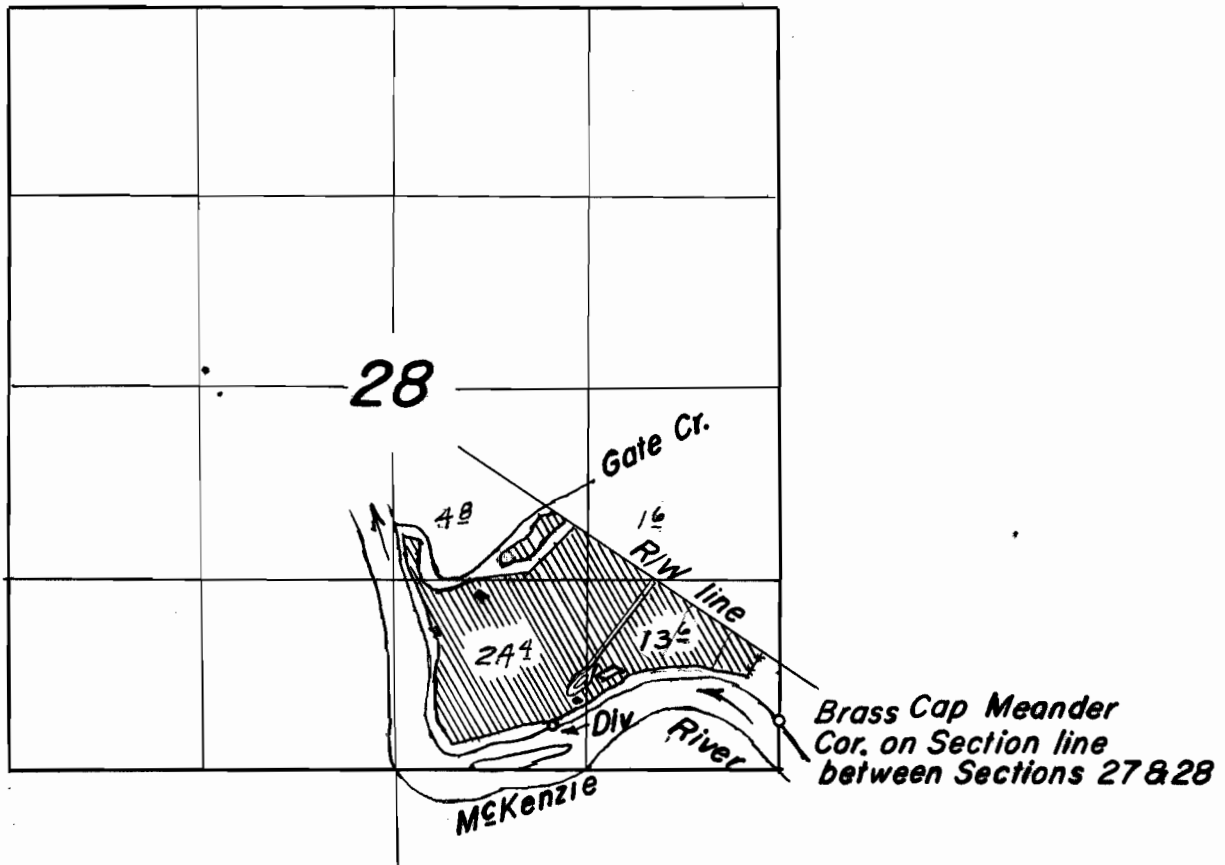

FINAL PROOF SURVEY
UNDER

Application No. 33494 Permit No. 26475
IN NAME OF

JUANITA F. CASSELMAN

Surveyed APRIL 19 1962, by C.O. Bartels
F.L. Siegmund