


T. 8S. R. 2W. W.M.

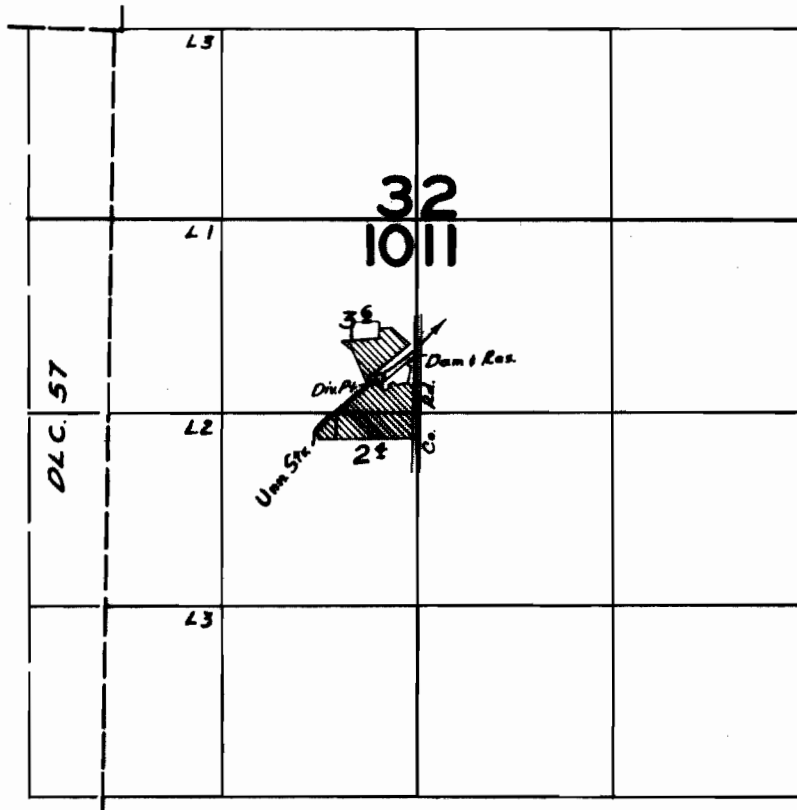

**FINAL PROOF SURVEY**

UNDER

R28168

R-1486

Application No. 28169 Permit No. 22167

IN NAME OF

.....DARYL E. OTJEN.....

Surveyed MAR.27. 1957., by C.O.BARTELS