


T. 3 N. R. 26 E. W. M.

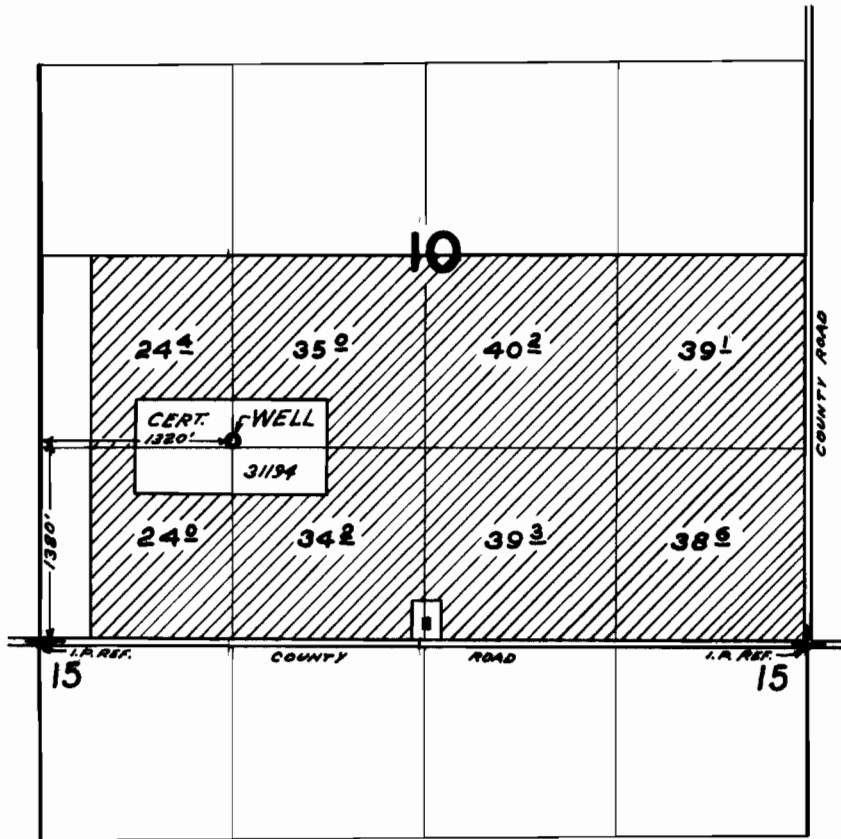

FINAL PROOF SURVEY UNDER

Application No. G-1413 Permit No. G-1322
IN NAME OF

ERNEST R. CRAMER

Surveyed AUG. 3 1966, by L. GOULD