


T. 10S., R. 6W., W.M.

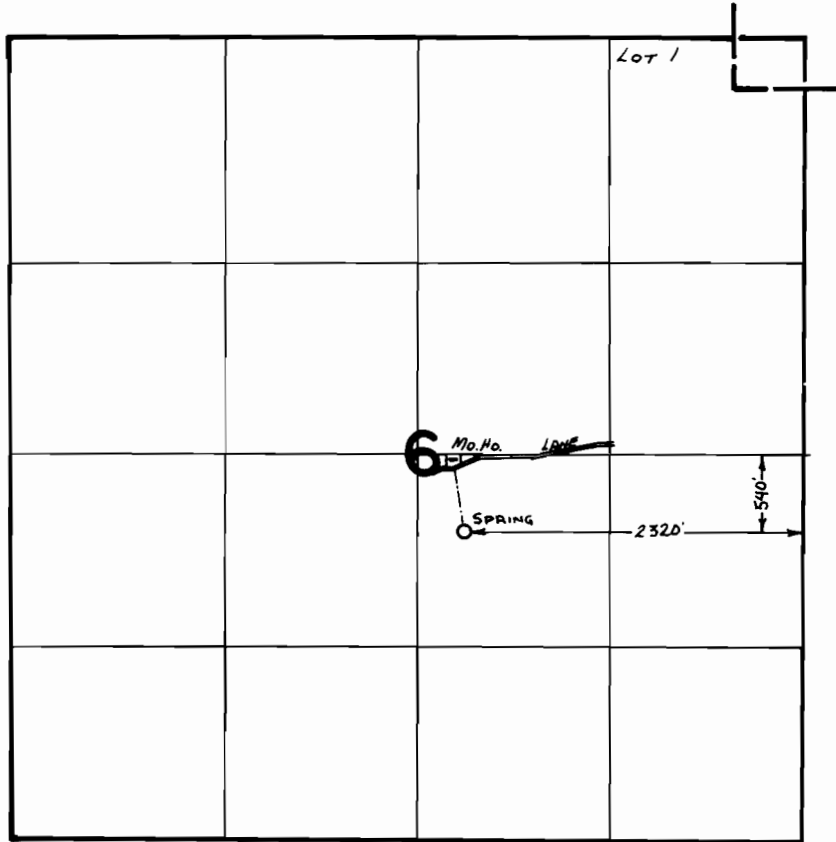

**FINAL PROOF SURVEY**  
UNDER

Application No. .47131.... Permit No. .35289.....  
IN NAME OF

.....C. A. JOHNSTON.....

Surveyed March. 28. 1973., by ..R.. MUCKEN.....