


G-2712

51946

35681

## T.5N.R.29E.W.M.

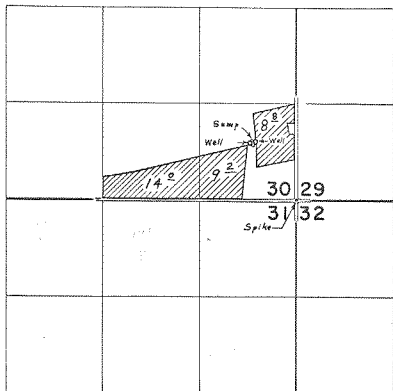

Wells Located; 800' N. &amp; 550' W., 780' N. &amp; 630' W. both From S.E. Cor. S. 30

**FINAL PROOF SURVEY**  
UNDER

Application No. G-2719 Permit No. G-2712

IN NAME OF

BYRON N. HALLSurveyed JAN. 23. 1967. by L. E. Gould

1967-U