


6249  
51998

T. 5N. R. 29E. W. M.

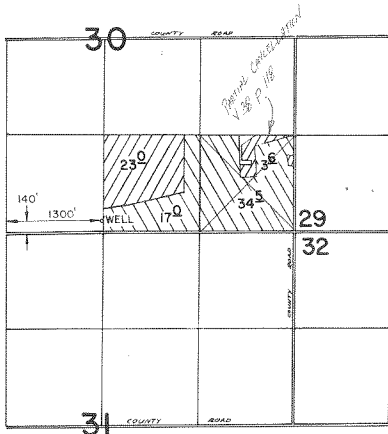

PRIMARY



SUPPL

**FINAL PROOF SURVEY**  
UNDER

Application No. G-6706 Permit No. G-6249  
IN NAME OF

LEWIS H. WILSON

Surveyed 2-13 1979, by R. BARWIN