



TOWNSHIP 9 S., RANGE 25 E.

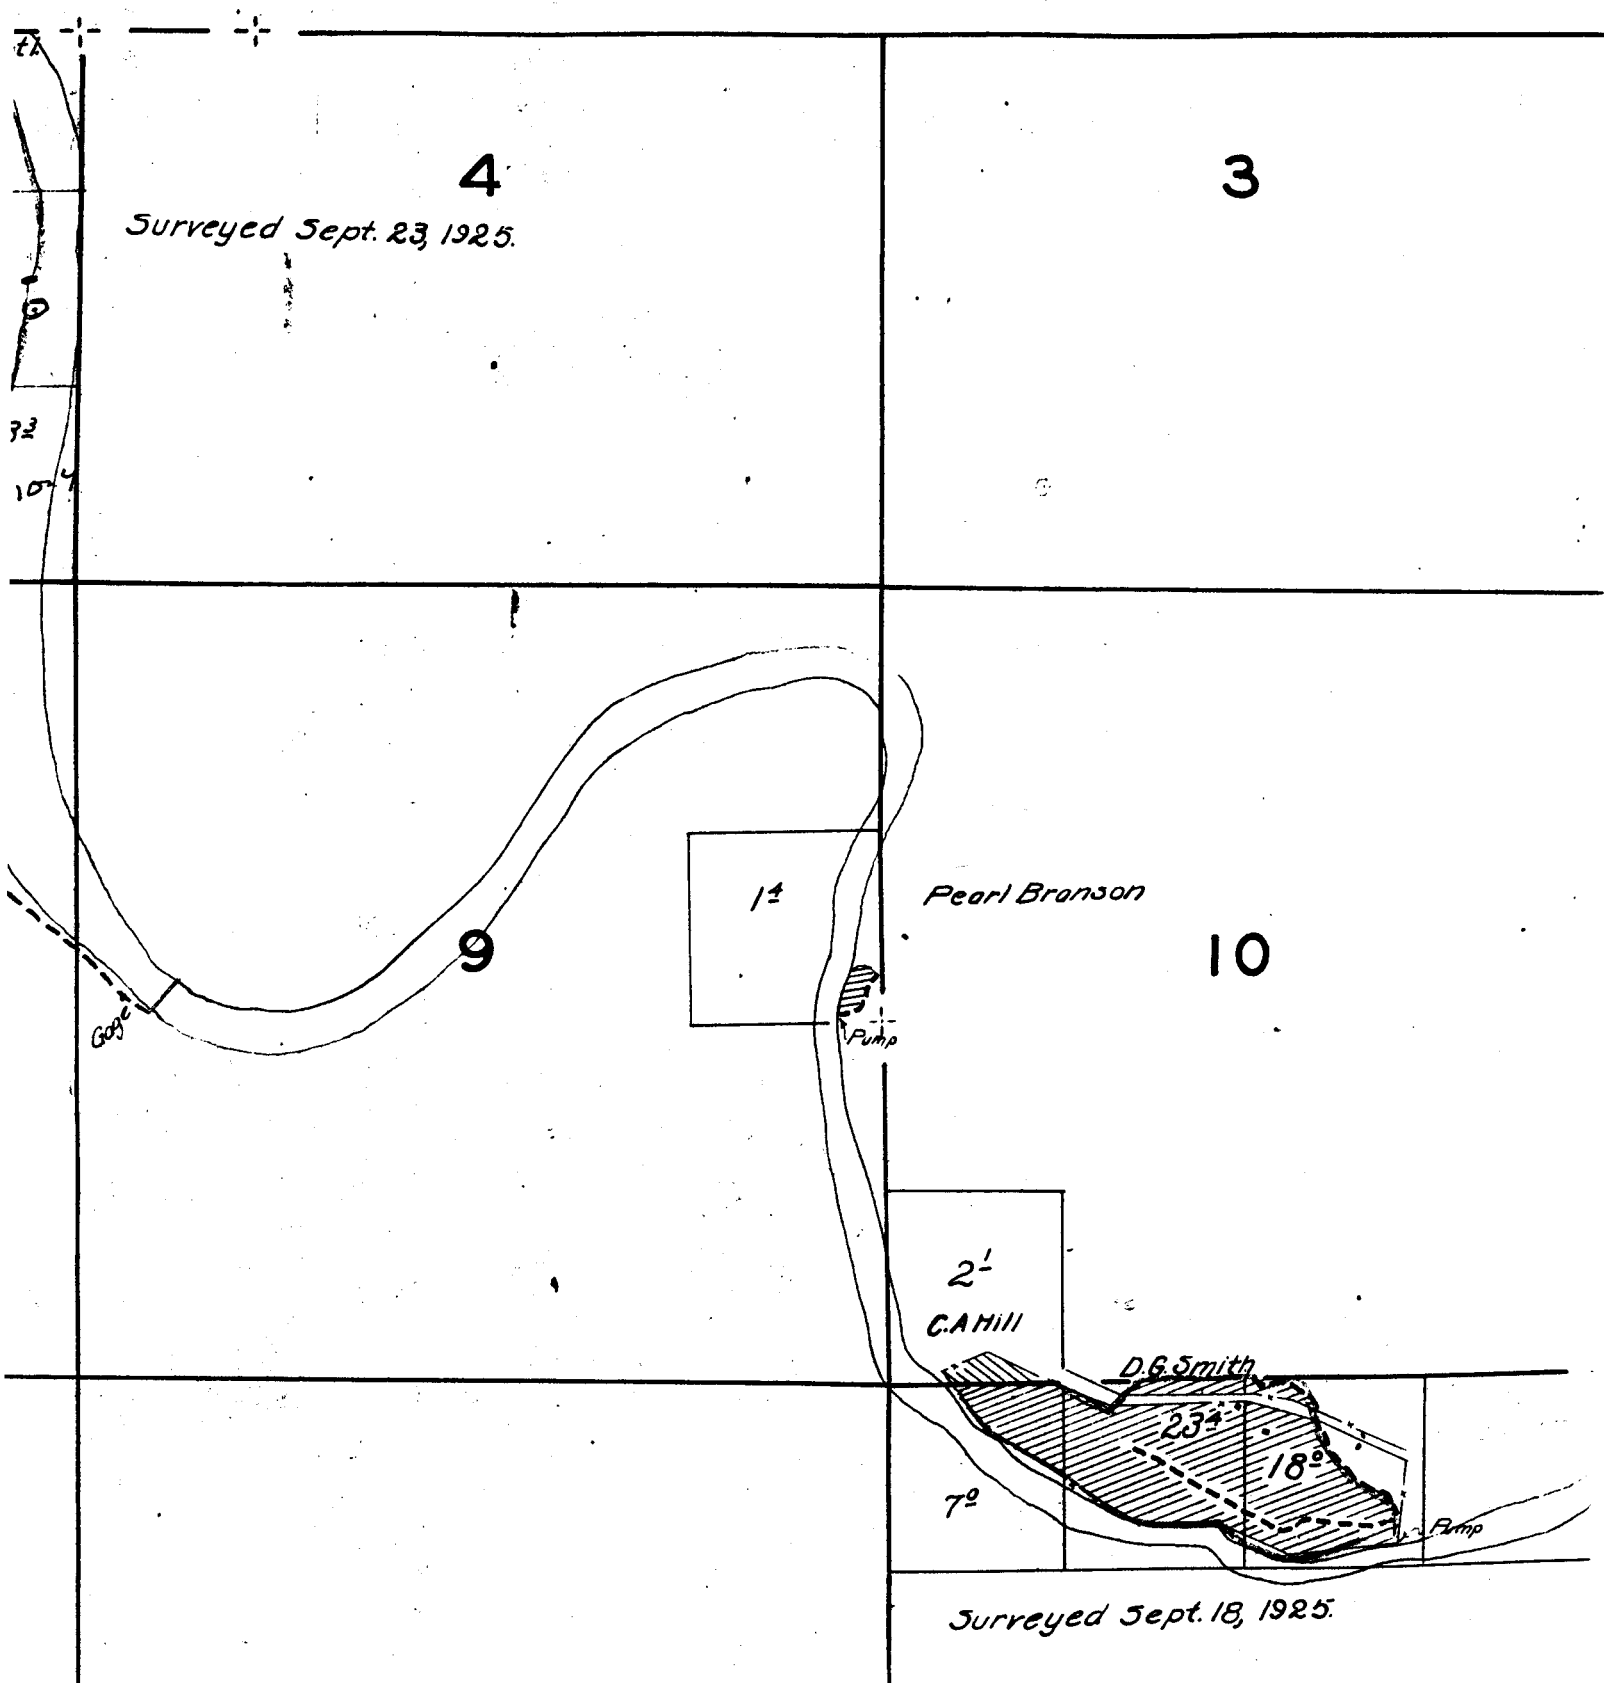

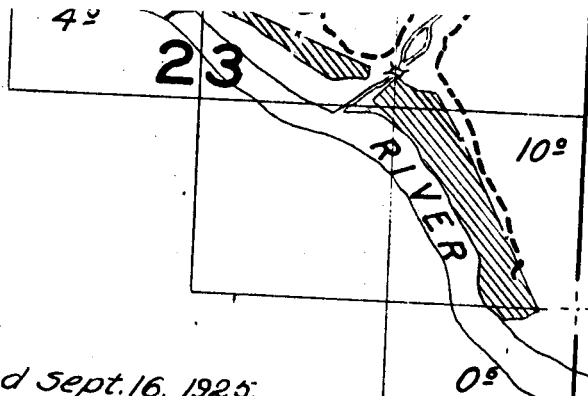

Surveyed Sept. 16, 1925.

24

26

25

35

36



18

17

16

19

20

21


29

Note: The location of streams, except in the vicinity of irrigated land, is sketched in approximate location.

28

32

33

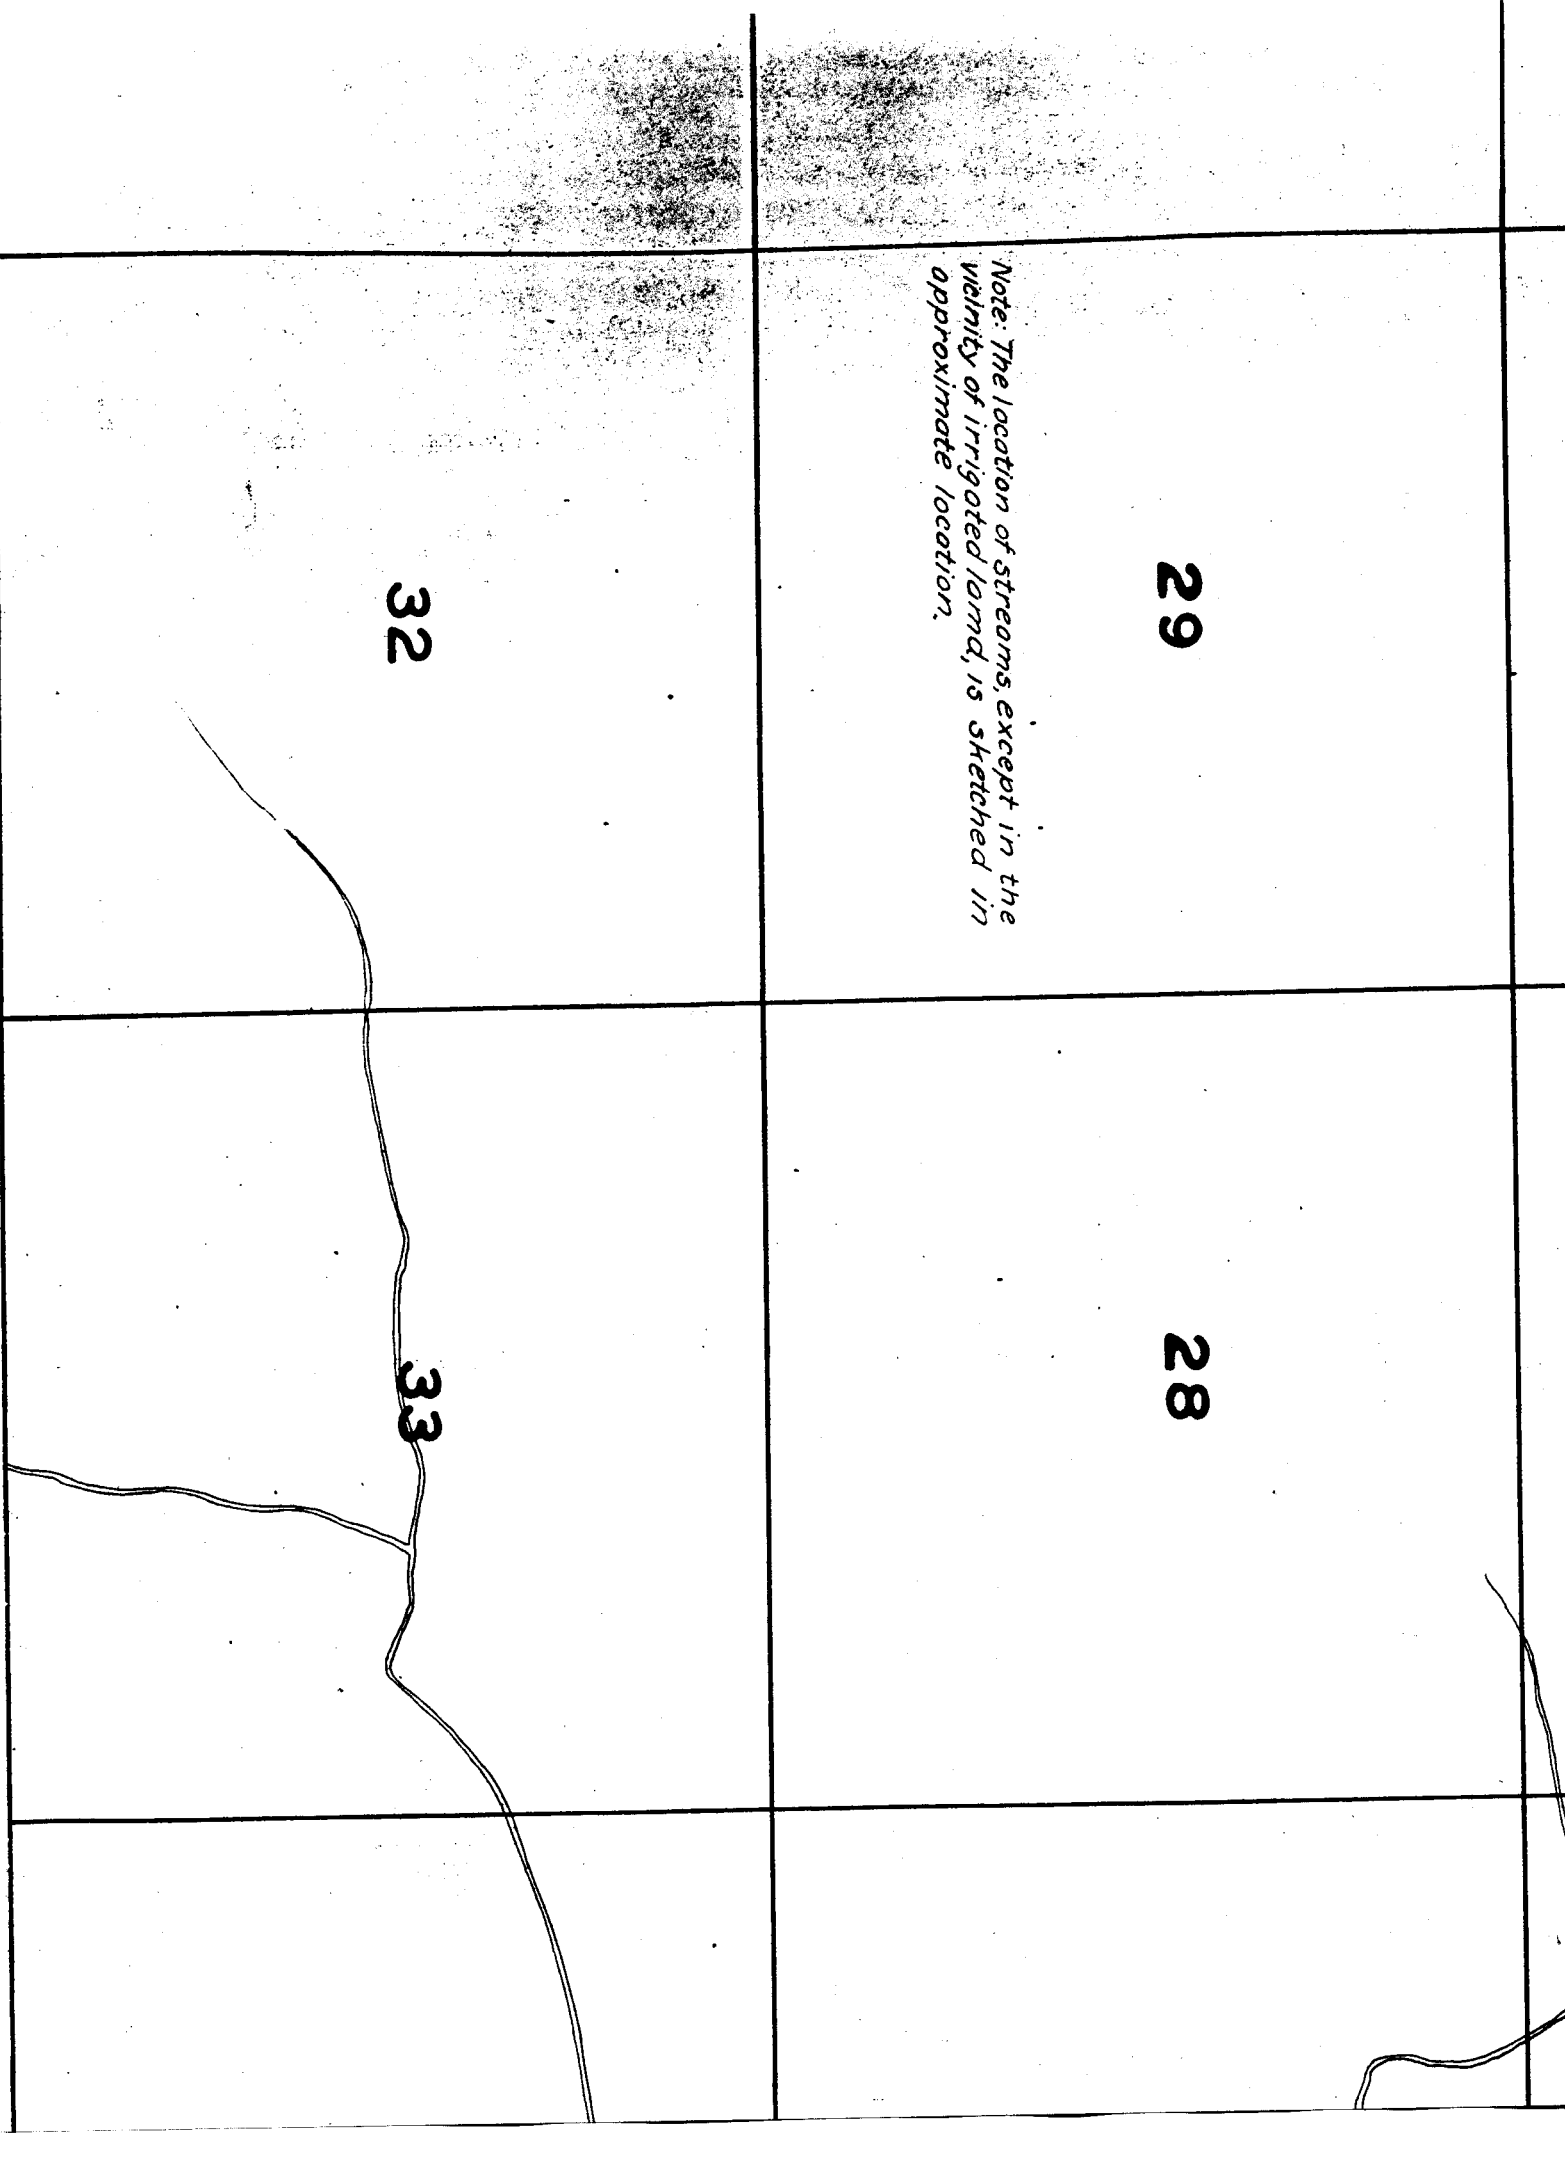

17

16

20


21

Surveyed Sept

72

DBS

23

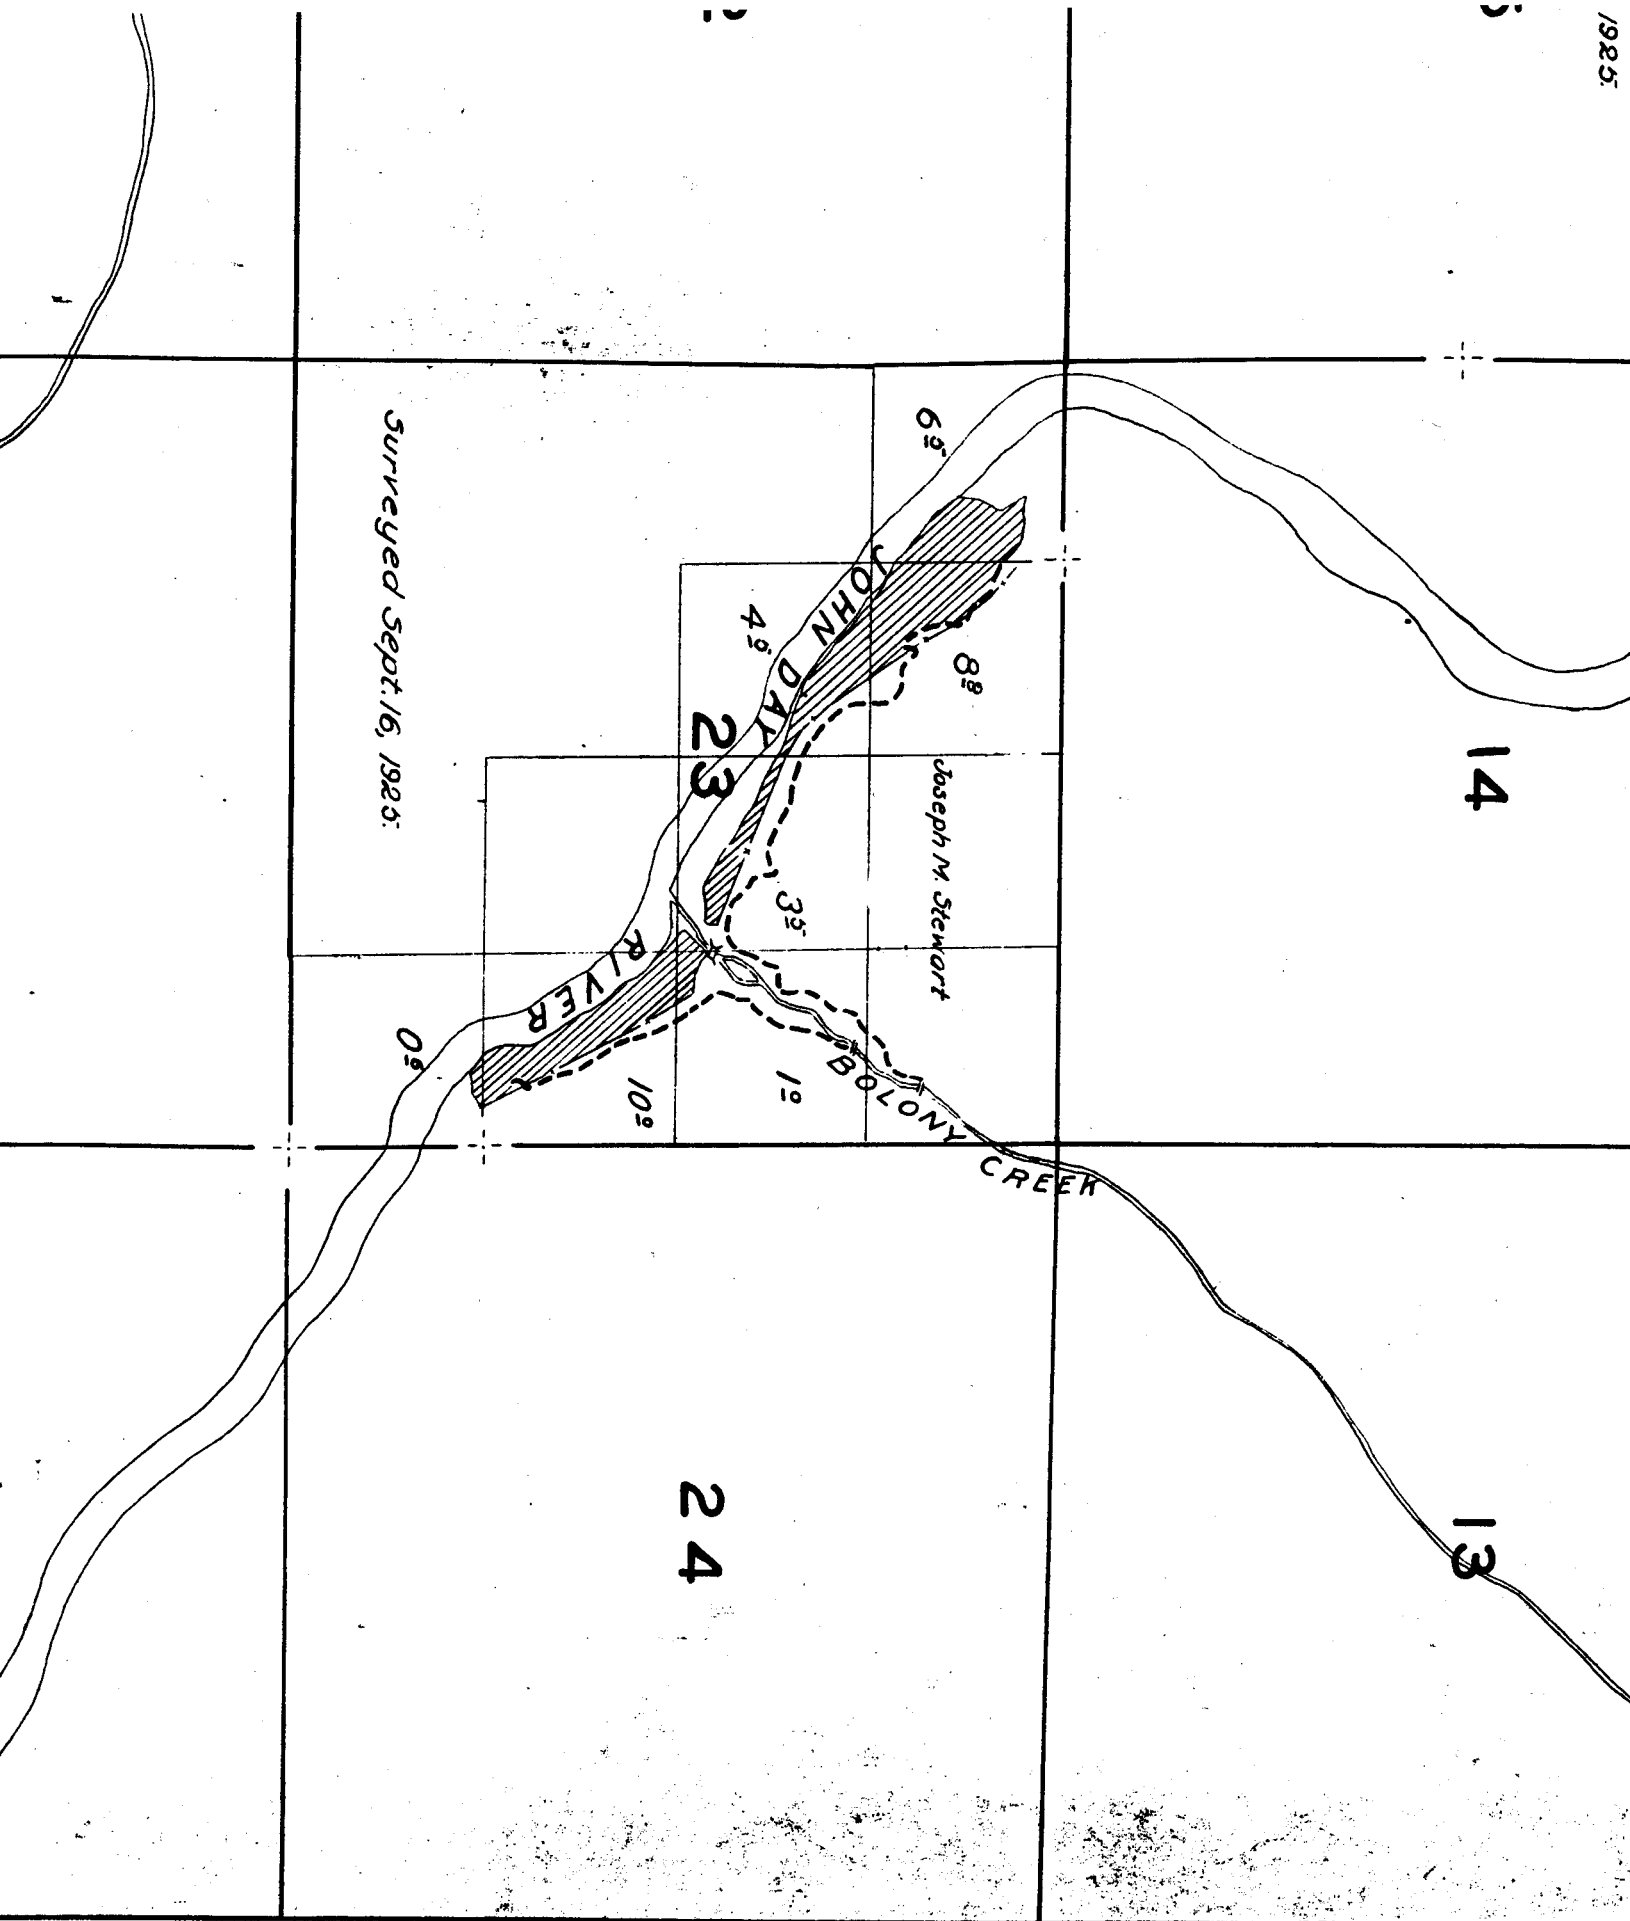

3


2

1

0

11

12

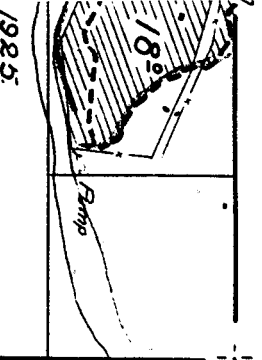

19

20

30

29

Note: The location of streams, except in the vicinity of irrigated land, is sketched in approximate location.

31

32

