


T. 18 2N., R. 24E., W.M.

FINAL PROOF SURVEY

APPL. G-6483 PER. G-5239
IN NAME OF

EMC ANDERSON

SURVEYED May 3 1972 BY R. Schmitt
Ave 24 1982, W. A. Arnold

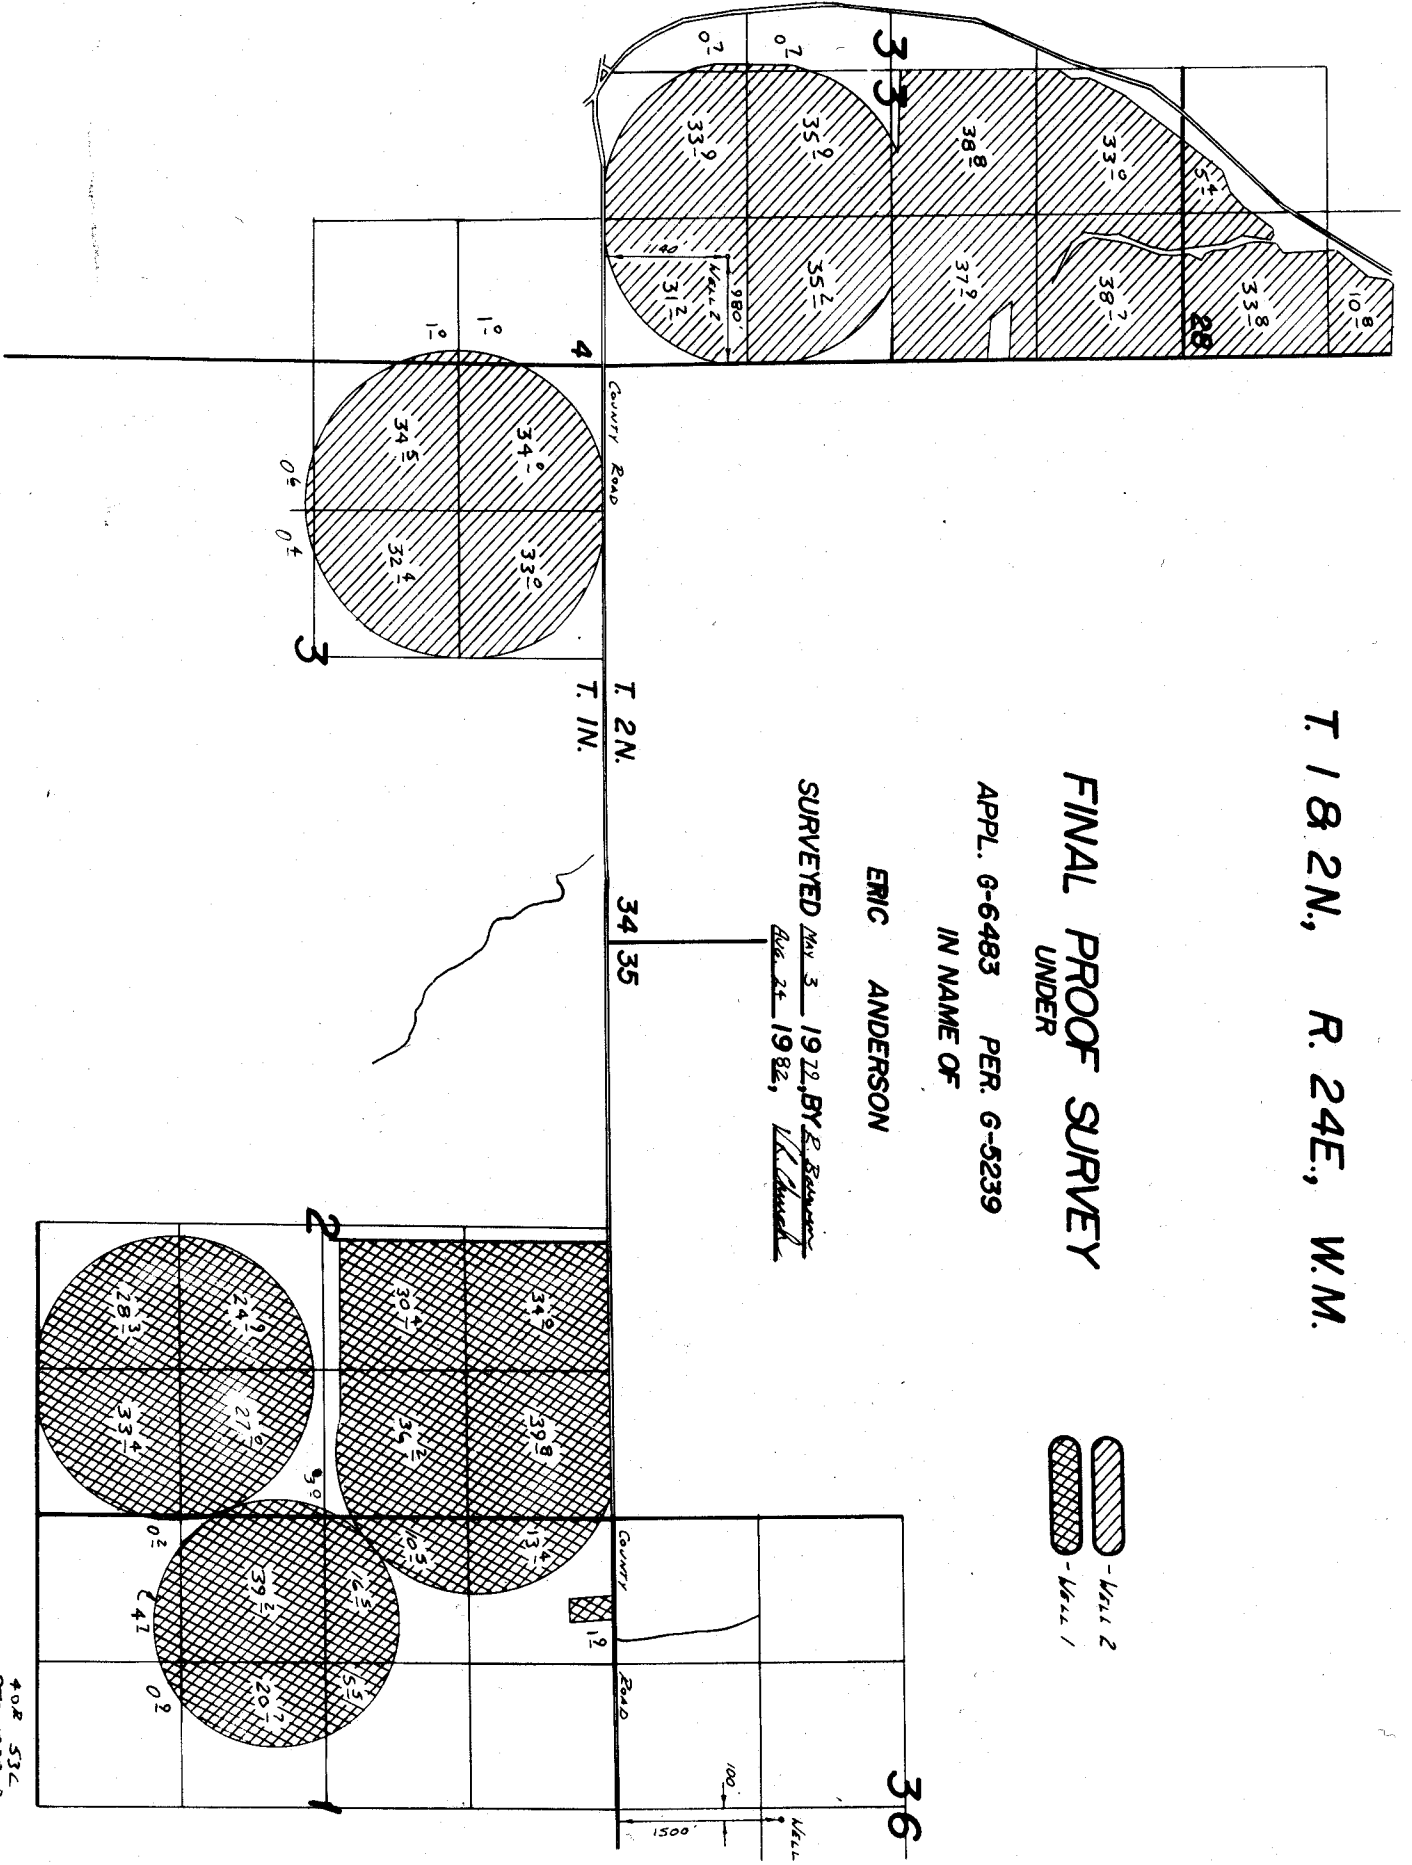

CC

CC

FOR 536
P75-1978-P-6
P75-1979-P-4