


T13S. R5W. WM.

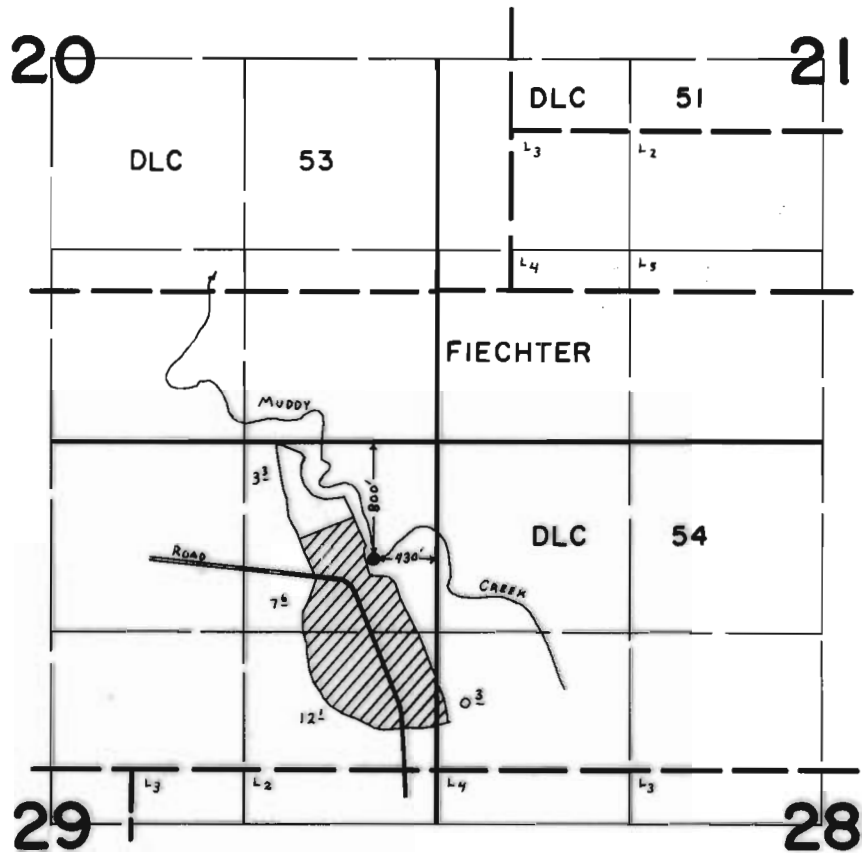

FINAL PROOF SURVEY UNDER

Application No. .51719... Permit No. .38985.....
IN NAME OF

FISH & WILDLIFE SERVICE

Surveyed .Sept. 4... 1979, by .C. L. HUGHES....