


T13S. R5W. WM.

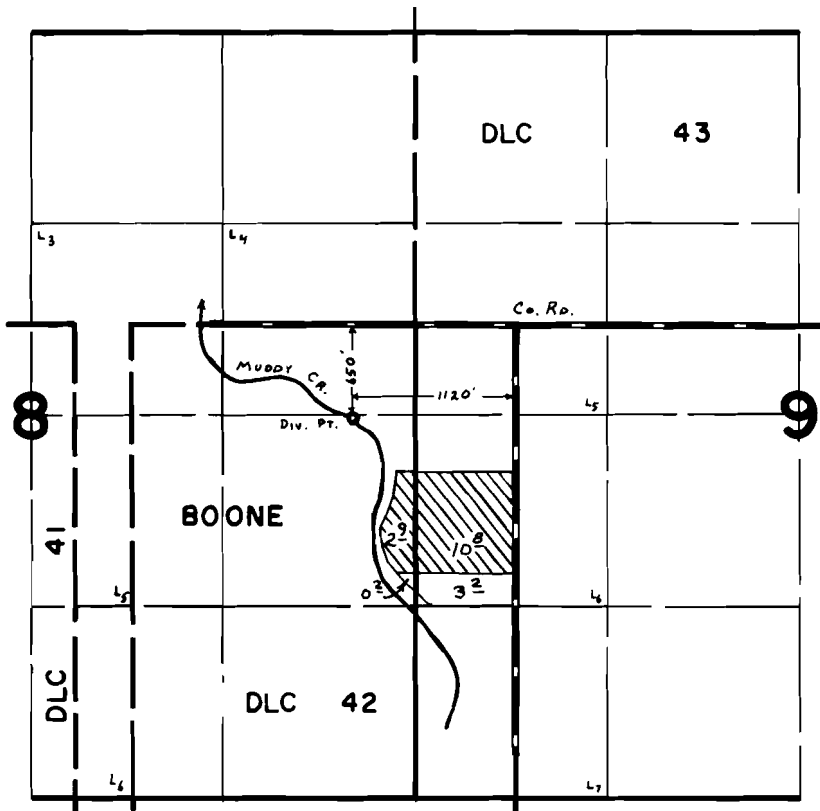

FINAL PROOF SURVEY UNDER

Application No. 55769.. Permit No. 41761.....
IN NAME OF

.....**ARCHIE H. RICE**.....

Surveyed Aug. 17. 1979, by C. L. HUGHES.....