


T5S. R1E. WM.

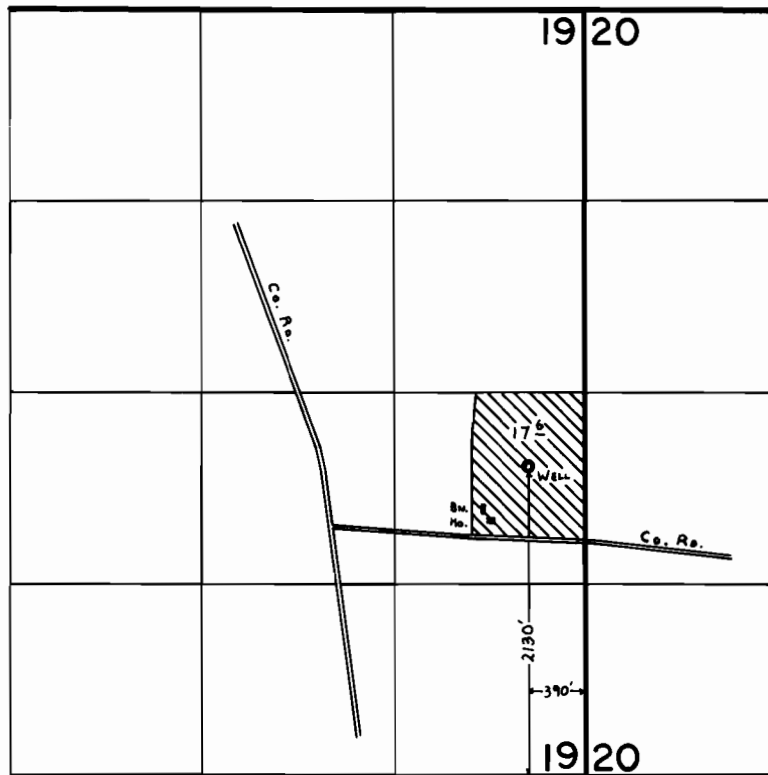

FINAL PROOF SURVEY UNDER

Application No. G-6423. Permit No. G-5998.
IN NAME OF

GRIGORY ANFILOFIEFF

Surveyed Oct. 12, 1979, by C. L. HUGHES